


253819-68

CKSON C.P.
WART B.A.
MAN H.C.
M: COPY
4-19-69 R.C.

RIV. 7A

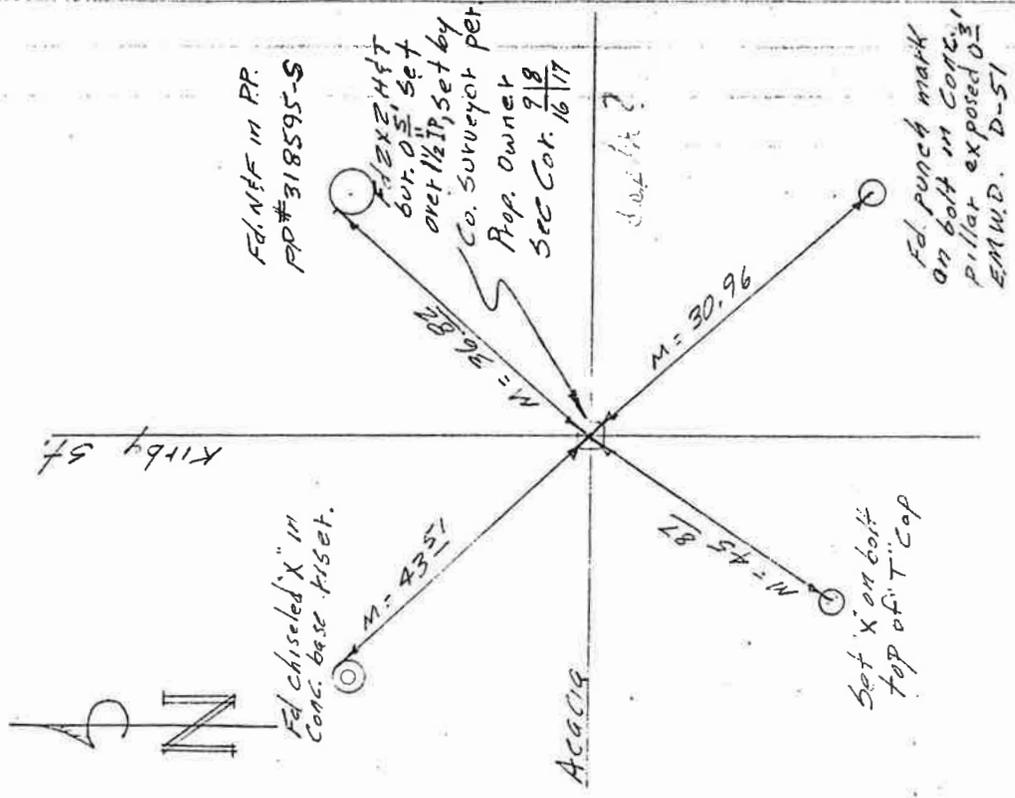


CORNER RECORD

Document Number 94-277

City of HEMET

County of RIVERSIDE, California

Brief Legal Description E KIRBY STREET & LATHAM AVE PER PM 77/83-84 IN
(Include: Sec., Twp., Rge., and Meridian or Rancho) SEC 9, T5S, R1W, SBM

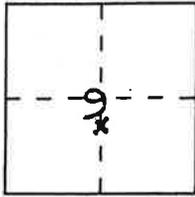

CORNER TYPE

Government Corner Control
Meander Property
Rancho Other
Date of Survey AUG 1994

COORDINATES
(Optional)

N. _____
E. _____
Zone _____ Datum _____
Elev. _____

Corner — Left as found Found and tagged Established Reestablished Rebuilt

Identification and type of corner found: Evidence used to identify or procedure used to establish or reestablish the corner:

Fd NAIL & TAG RCE 14237 FLUSH AT E-W INTERSECTION PER
PM 77/83-84, SET REF. POINTS @ 4 CORNERS INTERSECTION,
RESET 1 1/4" IP W/TAG LS 6054 IN CONC., FLUSH AFTER
STREET RECONSTRUCTION.

A description of the physical condition of the monument as found and as set or reset: _____

SURVEYOR'S STATEMENT

This Corner Record was prepared by me or under my direction in conformance with the Land Surveyors' Act on AUG 29 1994.

Signed Marvin Lee Lancaster L.S. or R.C.E. Number 6054



COUNTY SURVEYOR'S STATEMENT

This Corner Record was received Sept. 12 1994 and examined

and filed Sept. 12 1994

Signed Carole W. Beecroft Title Sup. Land Surveyor



County Surveyor's Comment _____

THE FILING OF THIS CORNER RECORD
DOES NOT RELIEVE THE SURVEYOR
FROM ANY RESPONSIBILITY OF THE
FILING OF A RECORD OF SURVEY

SCALE: 1" = 30'



STREET

LATHAM AVE

KIRBY

CONC NAIL IN CRACK JOINT

P.K. NAIL IN CRACK JOINT @ BCR.

CONC NAIL IN CRACK JOINT

CONC NAIL IN CURB HEAD

55.62

62.98

58.69

63.20

● FD NBS REFERENCE TAG AND NAIL AT SURFACE IN CENTER OF INTERSECTION, FLUSH, RCE 14232 PER PM 77/83-84.

AUG. 1994

SCALE: 1" = 30'

STREET

LATHAM AVE

KIRBY

CONC NAIL IN CRACK JOINT

P.K. NAIL IN CRACK JOINT @ B.C.R.

CONC NAIL IN CRACK JOINT

CONC NAIL IN CURB HEAD

55.60

62.98


58.59

63.20

● FD NBS REFERENCE TAG AND NAIL AT SURFACE IN CENTER OF INTERSECTION PCE 14232, PER PM 77/83-84.


CALIF CONTRACT SURVEY CO.
31 Nordan Ave.
Hemet, CA 92544
(909) 929-4486

CITY OF HEMET

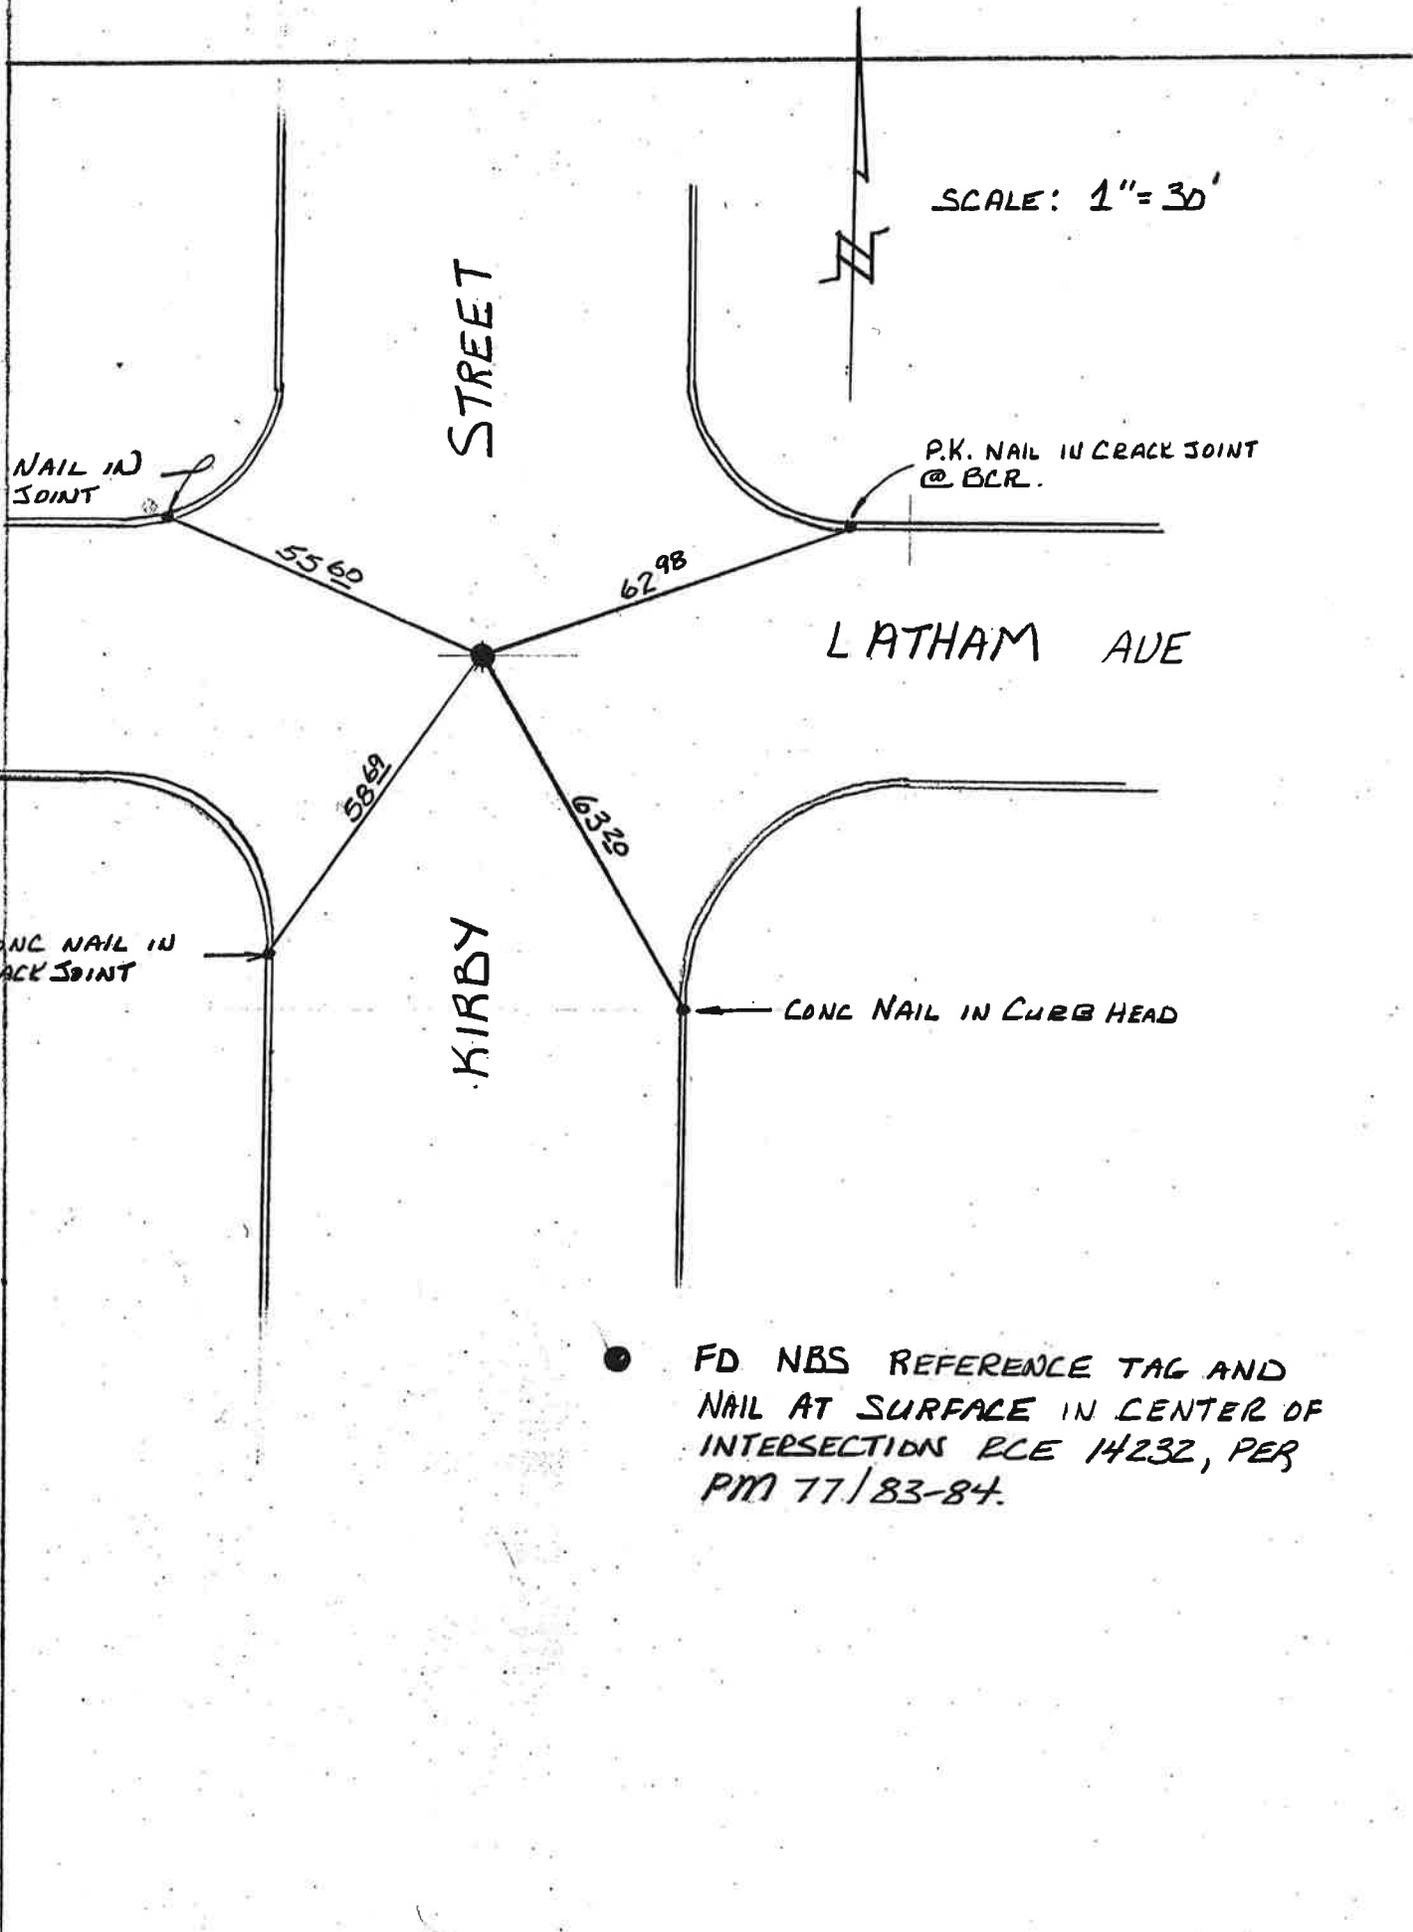

copy of J10000

450 E. Latham Ave., Hemet, CA 92343

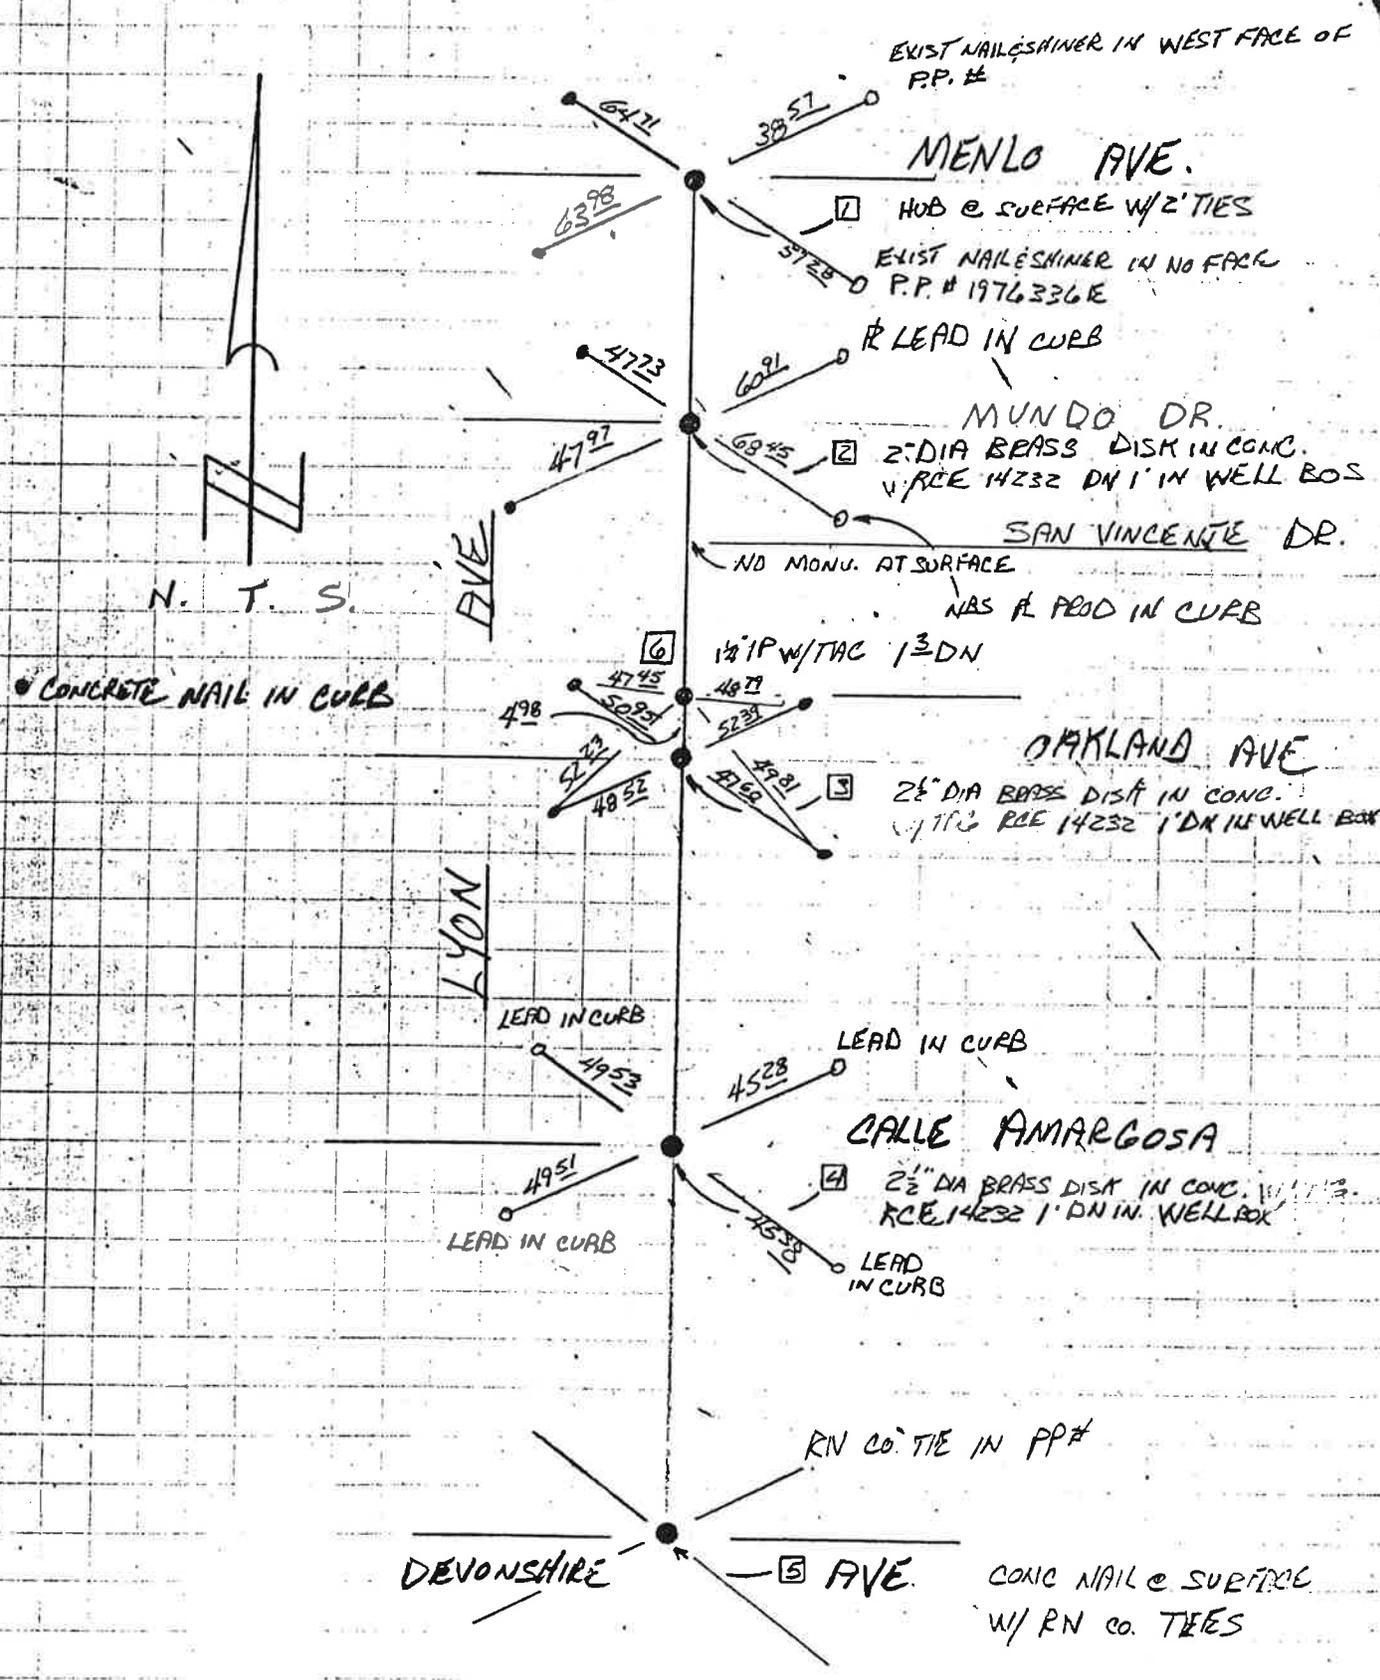

EXIST NAIL SHINER IN WEST FACE OF P.P. #

MENLO AVE.

1 HUB @ SURFACE W/ 2 TIES
EXIST NAIL SHINER IN NO FACE P.P. # 1976336E

R LEAD IN CURB

MUNDO DR.

2 DIA BRASS DISK IN CONC. W/ RCE 14232 DN 1' IN WELL BOS

SAN VINCENTE DR.

NO MONU. AT SURFACE

NAS R LEAD IN CURB

1 1/2" IP W/TAC 1 3/4 DN

OAKLAND AVE

2 DIA BRASS DISK IN CONC. W/ RCE 14232 1' DN IN WELL BOX

CALLE AMARGOSA

2 DIA BRASS DISK IN CONC. W/ RCE 14232 1' DN IN WELL BOX

RN CO. TIE IN P.P. #

DEVONSHIRE

5 AVE.

CONC NAIL @ SURFACE W/ RN CO. TIES

N. T. S.

AVE

CONCRETE NAIL IN CURB

LYON

LEAD IN CURB

LEAD IN CURB


LEAD IN CURB

LEAD IN CURB

MONUMENT TIES

SECTION 9 TOWNSHIP 5S RANGE 1W


City of Hemet
450 E. Latham Ave., Hemet, CA 92343

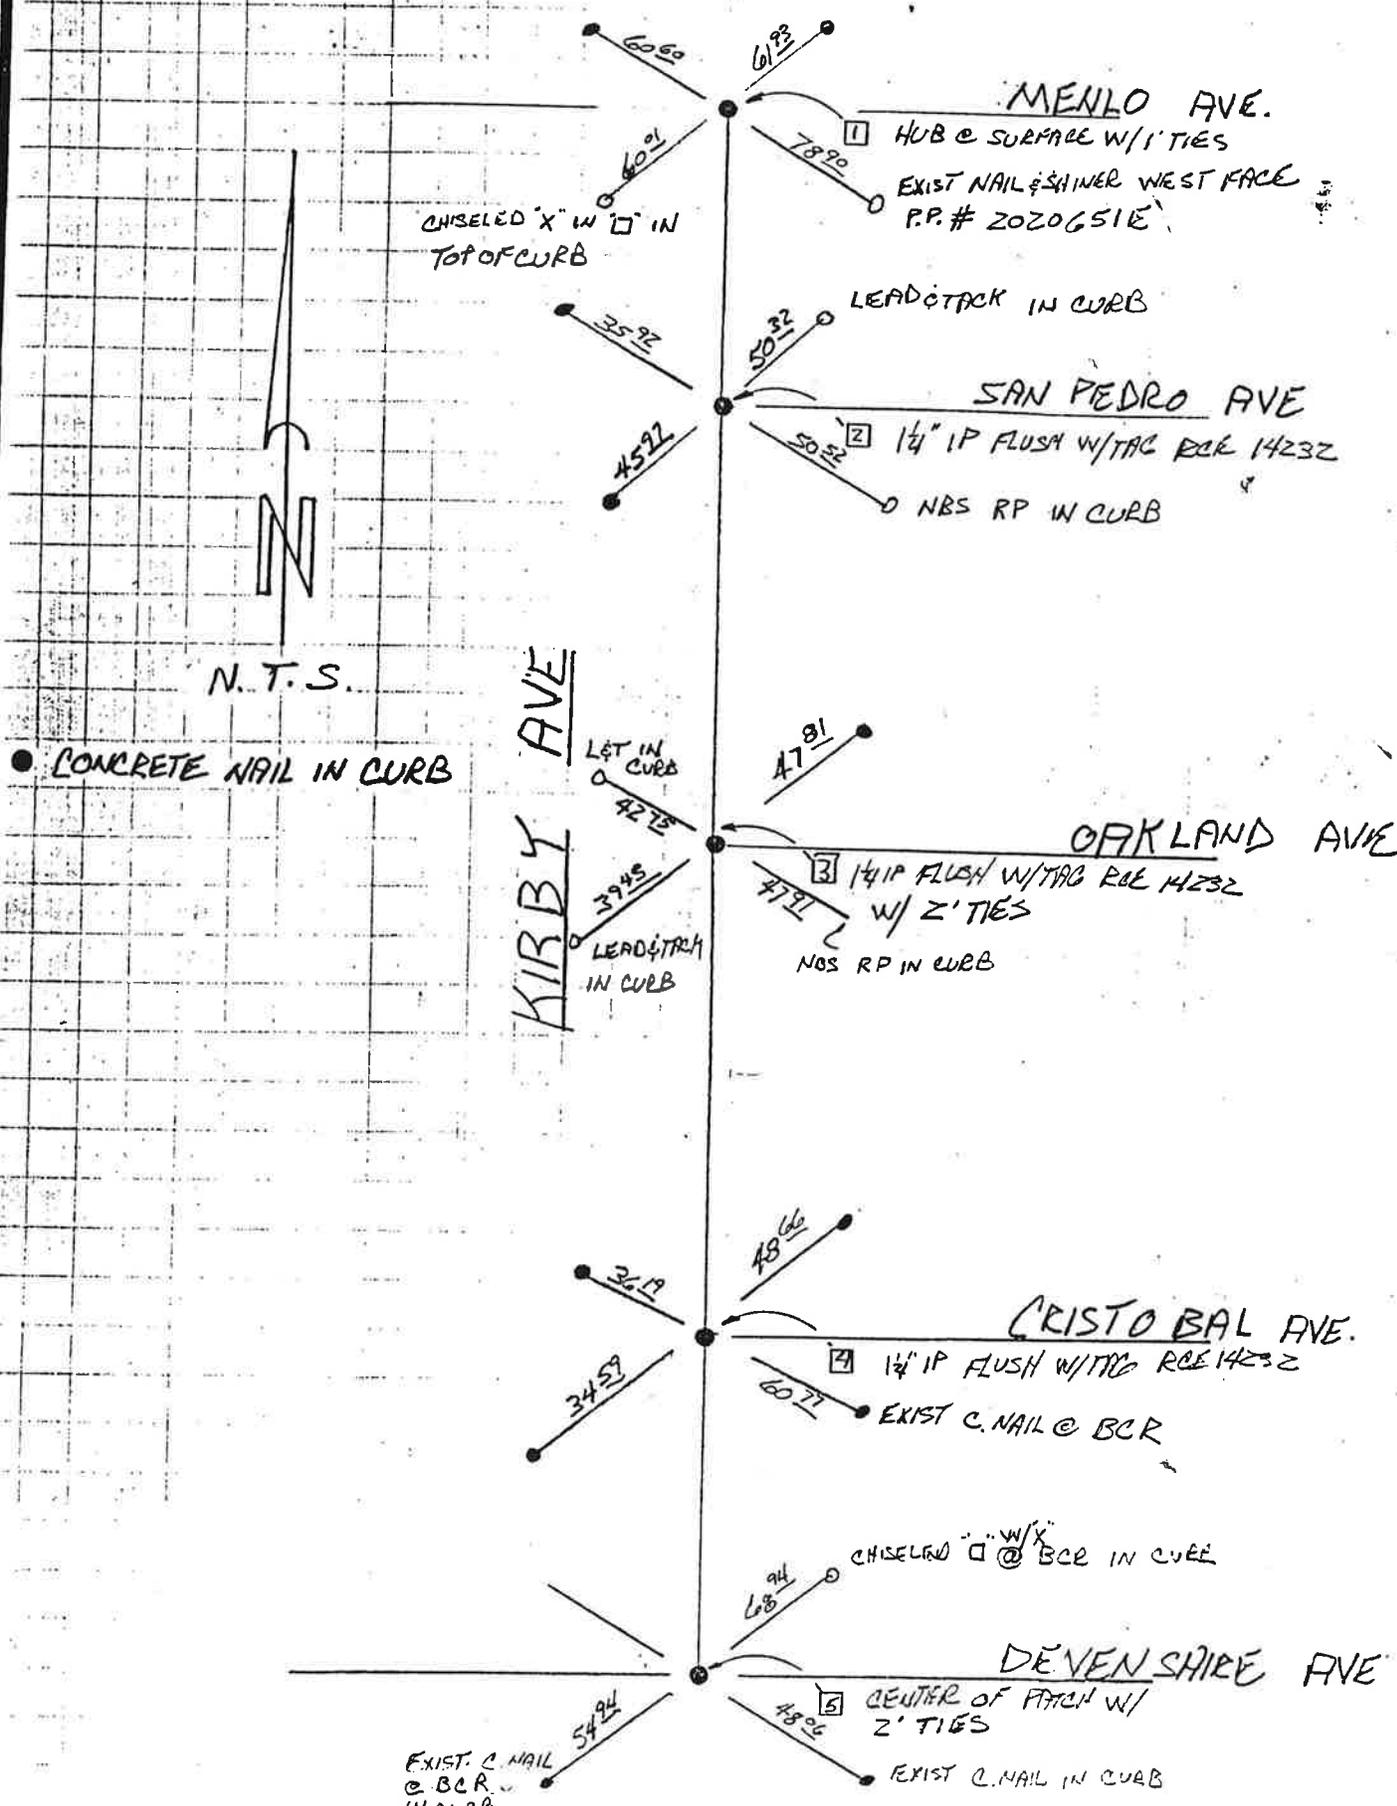

SEC. 9, TSS, RIW

SAN DIMAS ST.

2" DIA BRASS DISK IN CONC. L/E 340G?
1'DN IN WELL MONU.

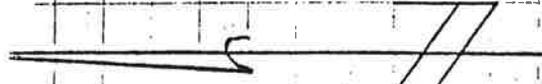

N.T.S.

CONCRETE NAIL IN CURB

PL PROD IN CURB

PL PROD. IN CURB

NBS RP TAG IN CURB

NBS RP TAG IN CURB

PL PROD IN CURB

NBS RP TAG IN CURB

SAN BANIA ST.

1 1/2" IP, FLUSH W/TAG
RCE 14Z32 W/2 TIES
LEAD IN CURB

SAN PASQUEL ST.

1 1/2" IP, FLUSH W/TAG
RCE 14Z32 W/2 TIES
PL PROD IN CURB



SAN ANSELMO ST

1 1/2" IP, FLUSH W/TAG
RCE 14Z32 W/2 TIES
NBS RP TAG IN CURB

KIRBY AVE.

OAKLAND AVE.

OAKLAND AVE.

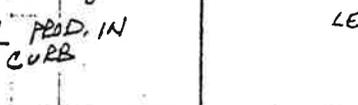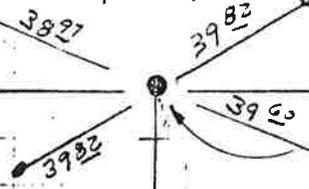

CONCRETE NAIL IN CURB

PL PROD IN CURB

PL PROD. IN CURB

NBS RP TAG IN CURB

NBS RP TAG IN CURB

PL PROD IN CURB

NBS RP TAG IN CURB

1 1/2" IP, FLUSH W/TAG
RCE 14Z32 W/2 TIES
LEAD IN CURB

1 1/2" IP, FLUSH W/TAG
RCE 14Z32 W/2 TIES
PL PROD IN CURB

1 1/2" IP, FLUSH W/TAG
RCE 14Z32 W/2 TIES
NBS RP TAG IN CURB

OAKLAND AVE.


OAKLAND AVE.

KIRBY AVE.

MONUMENT TIES

SECTION 9 TWP 5S RANGE 1W

○ ~ INDICATES CONC. NAIL ON TOP OF CURB

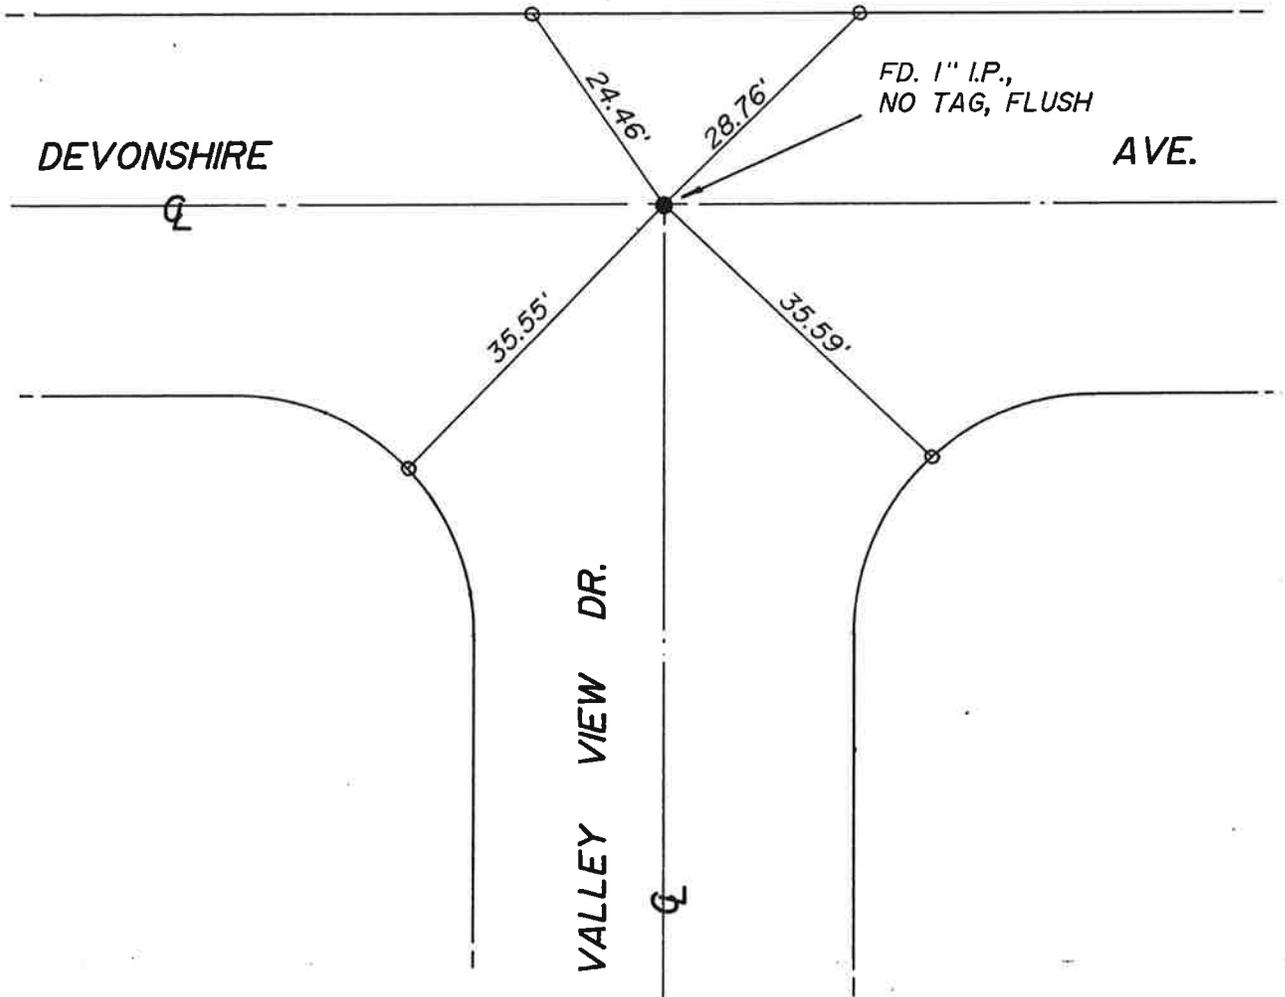

City of Hemet

480 EAST LATHAM AVENUE • HEMET, CALIFORNIA 92343 • (714) 658-6411




RIVERSIDE COUNTY SURVEY DEPARTMENT RECOVERY NOTES

F.B. 1085

SEC. 9 TWP. 5 S. RGE. 1 W.

DATE Nov. 2, 1971 TEMP. 51° W.O. NO. RR-3171
PARTY Stephenson, Drake, Neal, Carlson AGENCY San Jo. Surveyor

- ①
- ②
- ③
- ④ See T.B. 41/2
- ⑤ Fd. NET fl. 1 1/8" I.P. tagged L.S. 2831 dr. 18" fct R.S. 44/45. Set NET Y ties in post. of 2x2 wood 8-10 ft.
- ⑥
- ⑦
- ⑧
- ⑨

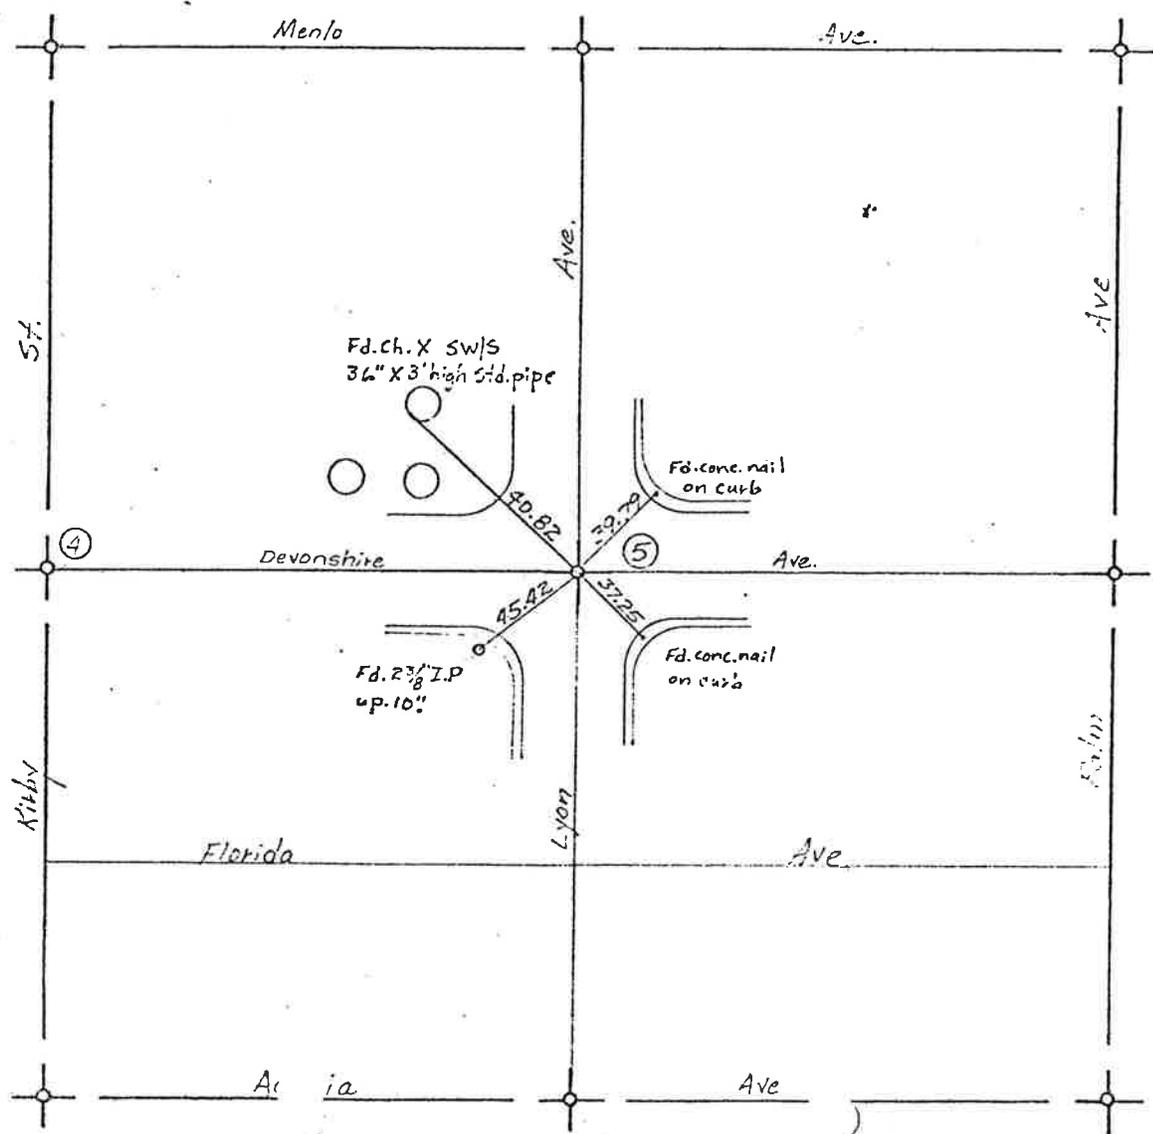


RIVERSIDE COUNTY SURVEY DEPARTMENT RECOVERY NOTES

FB, 1083

SEC. 9 TWP. 5 S. RGE. 1 W.

DATE Nov. 8, 1921 TEMP. 57° W.O. NO. 22-4774
 PARTY Stephenson, J. W. Neal, Corbett AGENCY Eng. Co. Surveyor

- ①
- ②
- ③
- ④ See T.B. 41/2
- ⑤ Fd. ch. X SW/S 36" X 3" high Sid. pipe 18" set S.S. 44/45. Set A.S. ties in corner of 7' x 2' hole
- ⑥
- ⑦
- ⑧
- ⑨
- ⑩

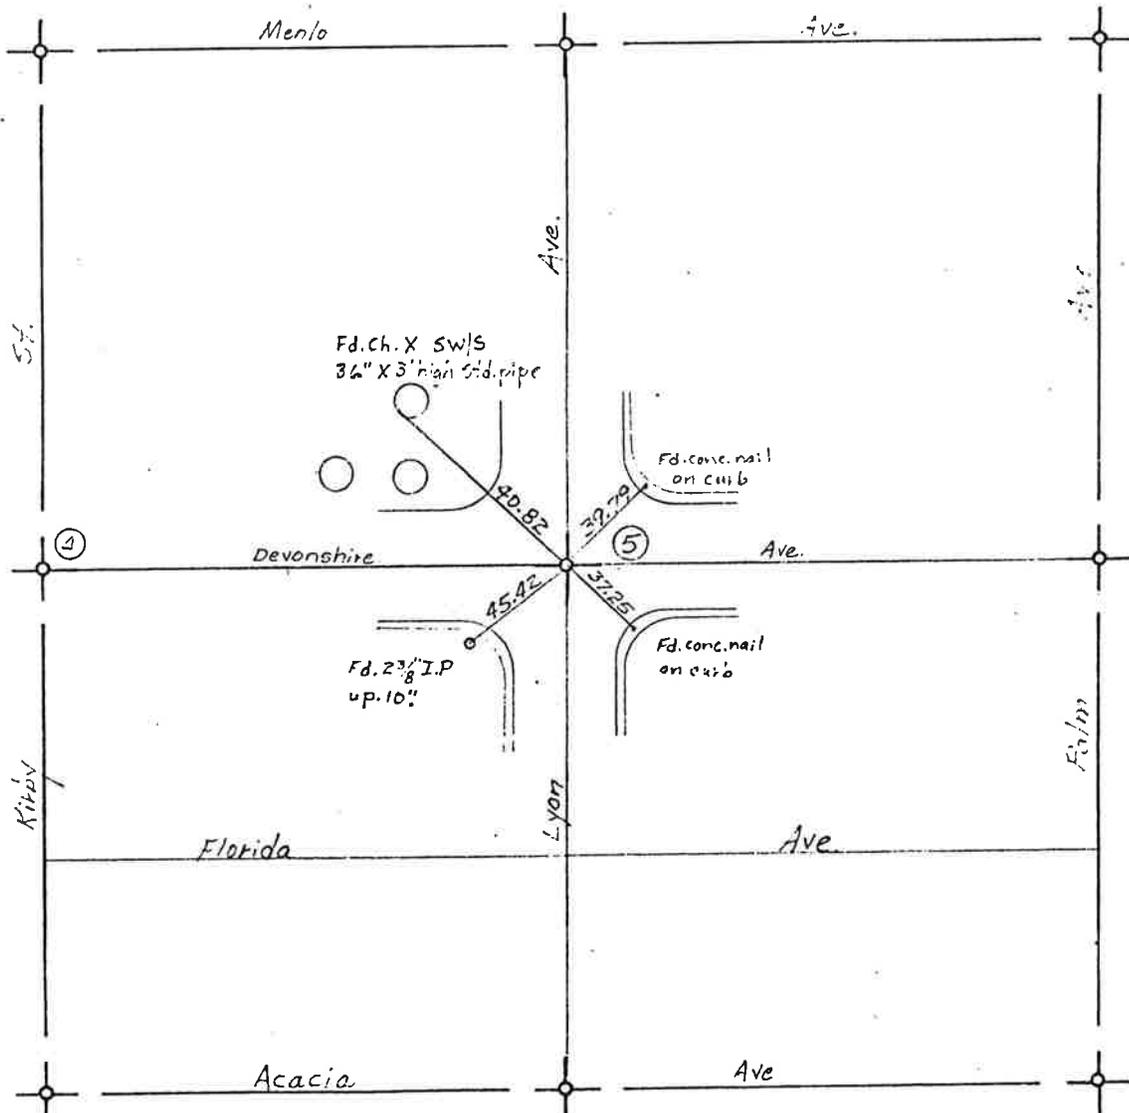


TIES NOTED IN TIE BOOK
 DATE 10-27-21
 BY [Signature]

66

CORNER RECORD

COUNTY OF IN THE CITY OF HEMET RIVERSIDE, CALIFORNIA

SEC. 9, T. 5S, R. 1W, SBM MERIDIAN

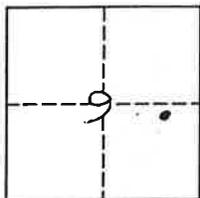

CORNER TYPE:		COORDINATES		
GOV'T. CORNER	<input type="checkbox"/>	CONTROL	<input checked="" type="checkbox"/>	N. _____
MEANDER	<input type="checkbox"/>	PROPERTY	<input type="checkbox"/>	E. _____
RANCHO	<input type="checkbox"/>	OTHER	<input type="checkbox"/>	ZONE _____

DATE OF SURVEY: NOV. 1990 ELEV. _____

CORNER - LEFT AS FOUND FOUND AND TAGGED REESTABLISHED REBUILT


PHYSICAL DESCRIPTION OF CORNER FOUND: EVIDENCE USED TO IDENTIFY THE CORNER FD NAIL AND TAG RCE #14232 AT SURFACE. REPLACED WITH 1/4" DD IP. W/ TAG LS #6054 AFTER ROAD RECONSTRUCTION AND OVERLAY. SET IN CONCRETE COLAR, FLUSH.

PHYSICAL DESCRIPTION OF MONUMENTS REBUILT, PERPETUATED, OR RESET SET 1/4" O.D IRON PIPE IN CONC., FLUSH AND TAGGED LS #6054.

A CORNER RECORD MAY BE USED TO REPORT THE RECOVERY OR PERPETUATION OF SURVEY MONUMENTS, OR TO SHOW THE REESTABLISHMENT OF MONUMENTS WHERE FIELD CONDITIONS AGREE SUBSTANTIALLY WITH RECORD

1. THE CORNER RECORD IS TO BE PREPARED BY A LICENSED LAND SURVEYOR OR REGISTERED CIVIL ENGINEER AND FILED WITH THE COUNTY SURVEYOR (OR COUNTY ENGINEER) OF THE COUNTY IN WHICH THE CORNER IS LOCATED.
2. A CORNER RECORD SHALL BE FILED WITHIN 90 DAYS OF THE DATE OF THE RECOVERY, USE OR REESTABLISHMENT OF A CORNER UNLESS THE CORNER IS TO BE SHOWN ON A RECORD OF SURVEY, PARCEL OR FINAL MAP DERIVED FROM THE SURVEY WHICH USED OR LOCATED SAID CORNER.
3. A CORNER RECORD MAY BE FILED TO SHOW THE PERPETUATION OF ANY EXISTING OR OBLITERATED CORNER OF THE SURVEY OF THE PUBLIC LANDS, AS SAID CORNERS ARE DEFINED IN THE "MANUAL OF INSTRUCTIONS FOR THE SURVEY OF PUBLIC LANDS OF THE UNITED STATES" OF THE BUREAU OF LAND MANAGEMENT. THE IDENTIFICATION OF SUCH CORNERS SHALL BE IF POSSIBLE IN ACCORDANCE WITH THE SYSTEM OF IDENTIFICATION GIVEN BY SAID MANUAL OF INSTRUCTIONS.
4. AT THE OPTION OF THE SURVEYOR OR ENGINEER, A CORNER RECORD MAY BE FILED FOR PROPERTY CORNERS, PROPERTY CONTROLLING CORNERS, REFERENCE MONUMENTS OR ACCESSORIES TO PROPERTY CORNERS WHEN THE COUNTY SURVEY OR COUNTY ENGINEER DETERMINES THAT NONE OF THE CONDITIONS REQUIRING A RECORD OF SURVEY EXIST AS OUTLINED IN SECTION 8762 OF THE LAND SURVEYORS ACT.
5. THE COUNTY SURVEYOR OR COUNTY ENGINEER SHALL EXAMINE THE CORNER RECORD WITHIN 20 DAYS FOR CONFORMANCE WITH SECTION 8773 OF THE LAND SURVEYORS ACT. UPON DETERMINATION THAT THE ABOVE LISTED CONDITIONS ARE SATISFIED AND THAT THE INFORMATION REQUIRED ELSEWHERE ON THIS FORM IS COMPLETE. THE COUNTY SURVEYOR OR ENGINEER SHALL FILE AND INDEX THE CORNER RECORD AND NOTIFY THE SURVEYOR/ENGINEER OF SUCH FILING.
6. CORNER RECORDS SUBMITTED FOR SURVEYS WHICH, UNDER SECTION 8762 OF THE LAND SURVEYORS ACT, REQUIRE A RECORD OF SURVEY SHALL BE RETURNED TO THE SURVEYOR OR ENGINEER TOGETHER WITH A STATEMENT OF THE REASON FOR SUCH RETURN.
7. CALIFORNIA COORDINATE SYSTEM DATA MAY BE SHOWN, BUT SHOULD BE ACCOMPANIED BY AN IDENTIFICATION OF THE SOURCE OF SUCH INFORMATION.
8. A SKETCH SHOWING REFERENCE TIES TO ACCESSORIES OR OTHER IDENTIFIABLE OBJECTS IN THE VICINITY OF THE CORNER SHALL BE PROVIDED WHERE APPROPRIATE. PHOTOGRAPHS AND/OR TOPOGRAPHY OF THE MONUMENT AND SURROUNDING AREA ARE ENCOURAGED.

COUNTY OF RIVERSIDE, CALIFORNIA

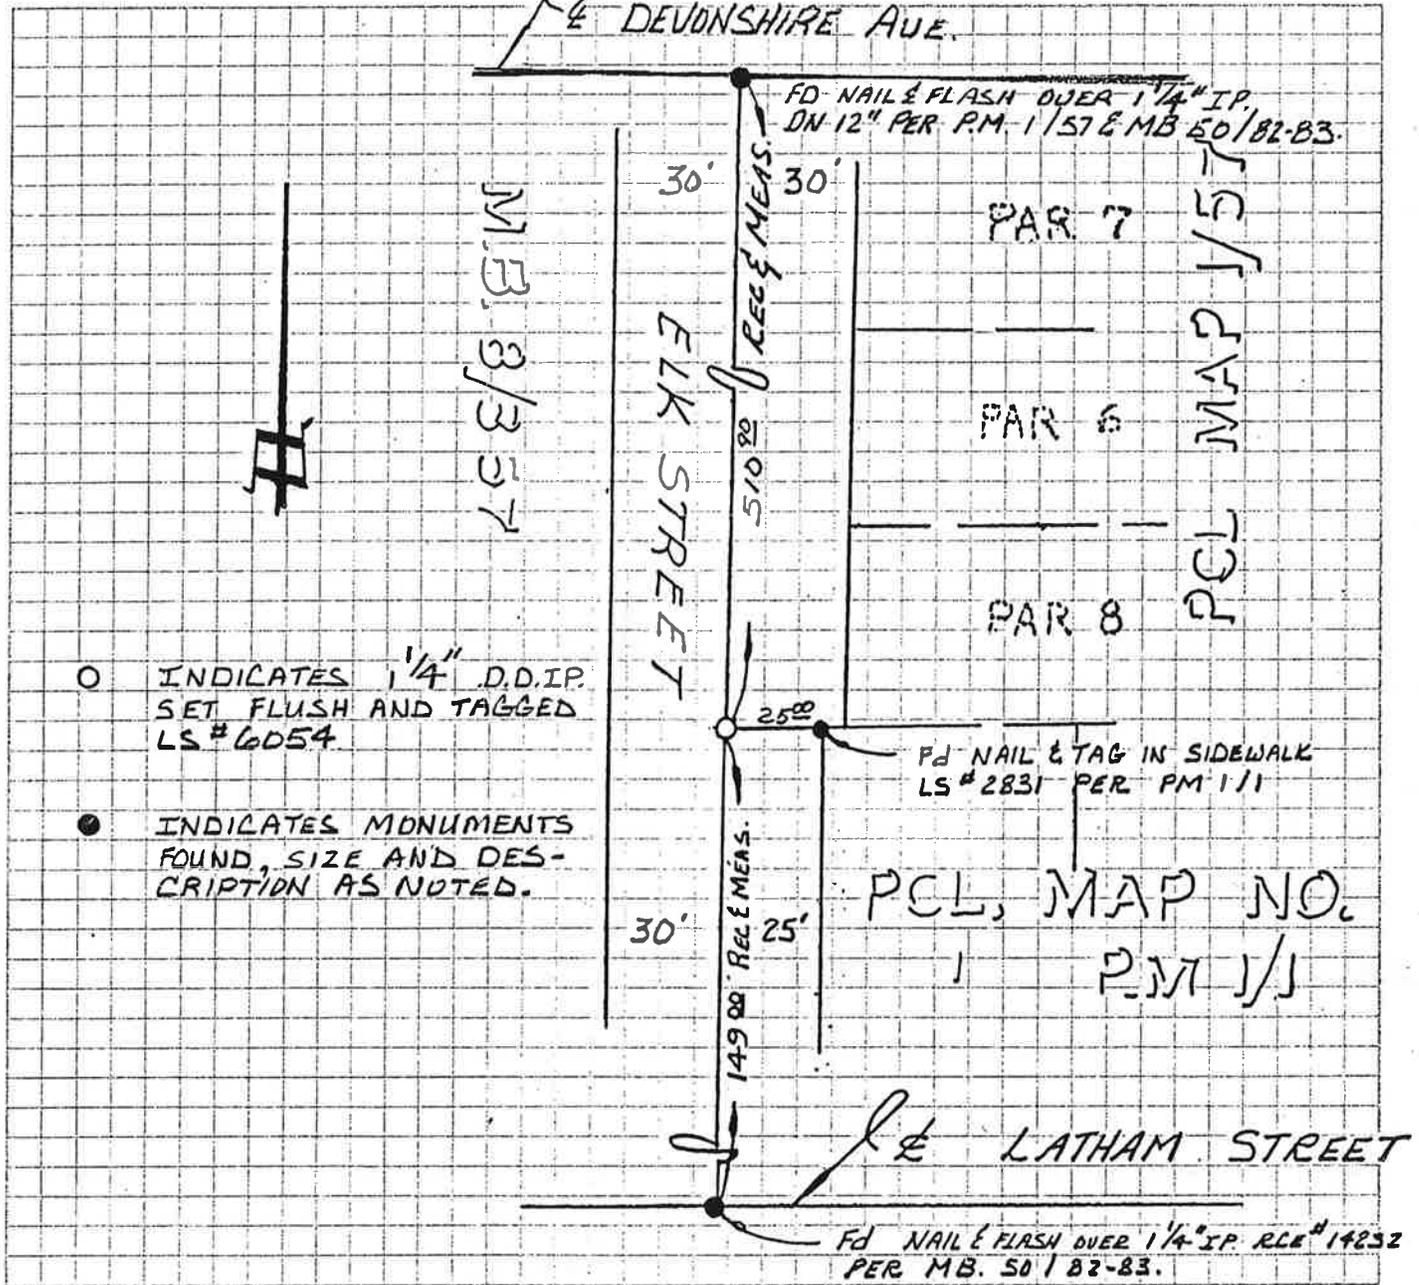

- INDICATES 1/4" D.D.I.P. SET FLUSH AND TAGGED LS # 6054.
- INDICATES MONUMENTS FOUND, SIZE AND DESCRIPTION AS NOTED.


SURVEYOR'S CERTIFICATE

THIS CORNER RECORD WAS PREPARED BY ME OR UNDER MY DIRECTION IN ACCORDANCE WITH THE LAND SURVEYORS ACT

19 90

SIGNED: Marvin E. Lancaster

L.S. OR R.C.E. NO.: 6-30-93

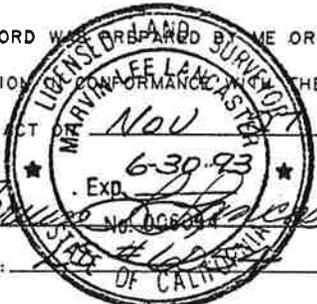

COUNTY SURVEYOR'S CERTIFICATE

THIS CORNER RECORD WAS RECEIVED Dec. 6 19 90

AND EXAMINED AND FILED Dec. 7 19 90

BY: Douglas W. Biecroft

TITLE: Serp. Land Surveyor




COUNTY SURVEYOR'S STATEMENT:

THIS FORM PREPARED BY THE LEAGUE OF CALIFORNIA SURVEYING ORGANIZATIONS, SOUTHERN REGION

MONUMENT TIES

SECTION 9 TOWNSHIP 5S RANGE 1W

TRACT NO. 18733-2

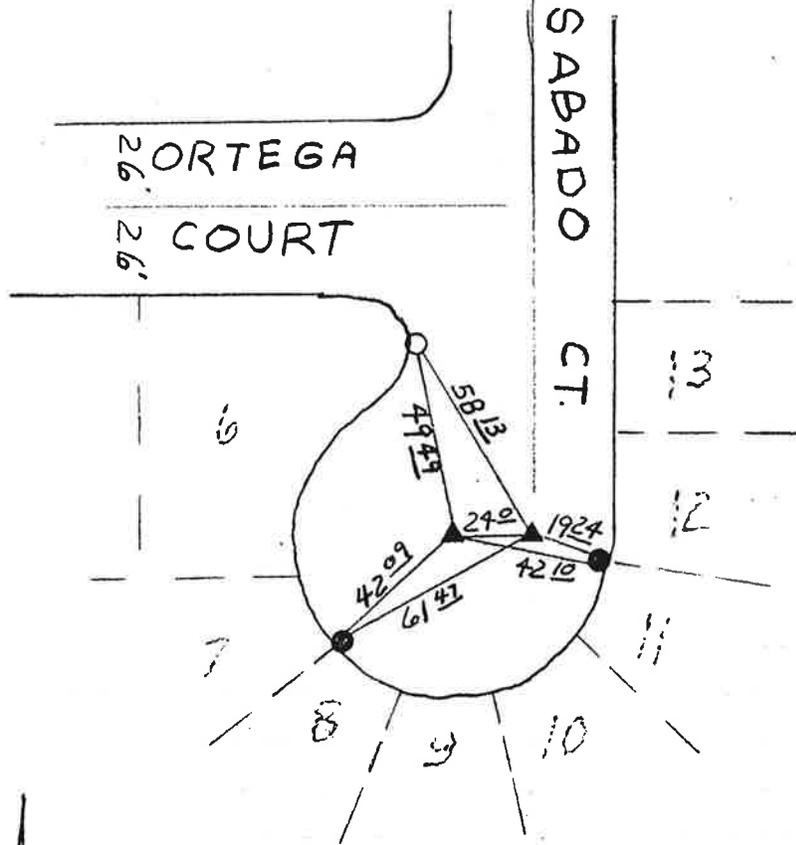

- ▲ SURVEY MONUMENT PER. CITY OF HEMET STDS. M-900, M-900A & M-901.
- NAIL & TAG RCE 26406 IN TOP OF CURB.
- CONCRETE NAIL IN TOP OF CURB.




11/90

MONUMENT TIES

SECTION 9 TOWNSHIP 55 RANGE 1W


TRACT NO. 18733-2

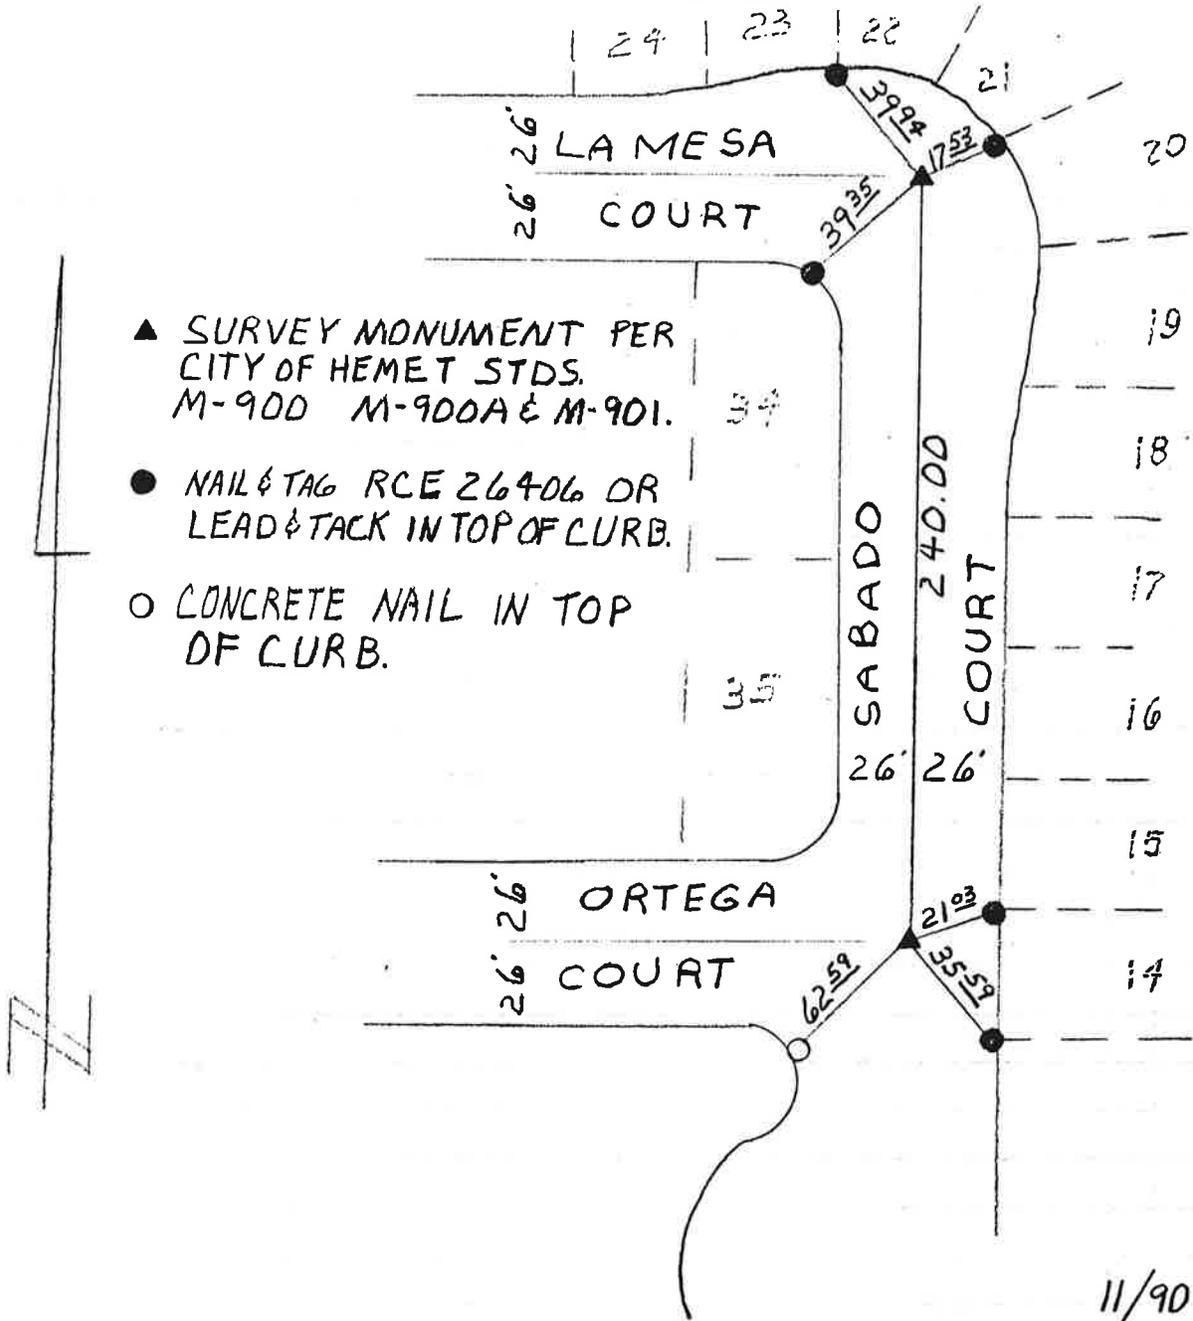

MONUMENT TIES

SECTION 9 TOWNSHIP 5S RANGE 1W

TRACT NO. 18733-2

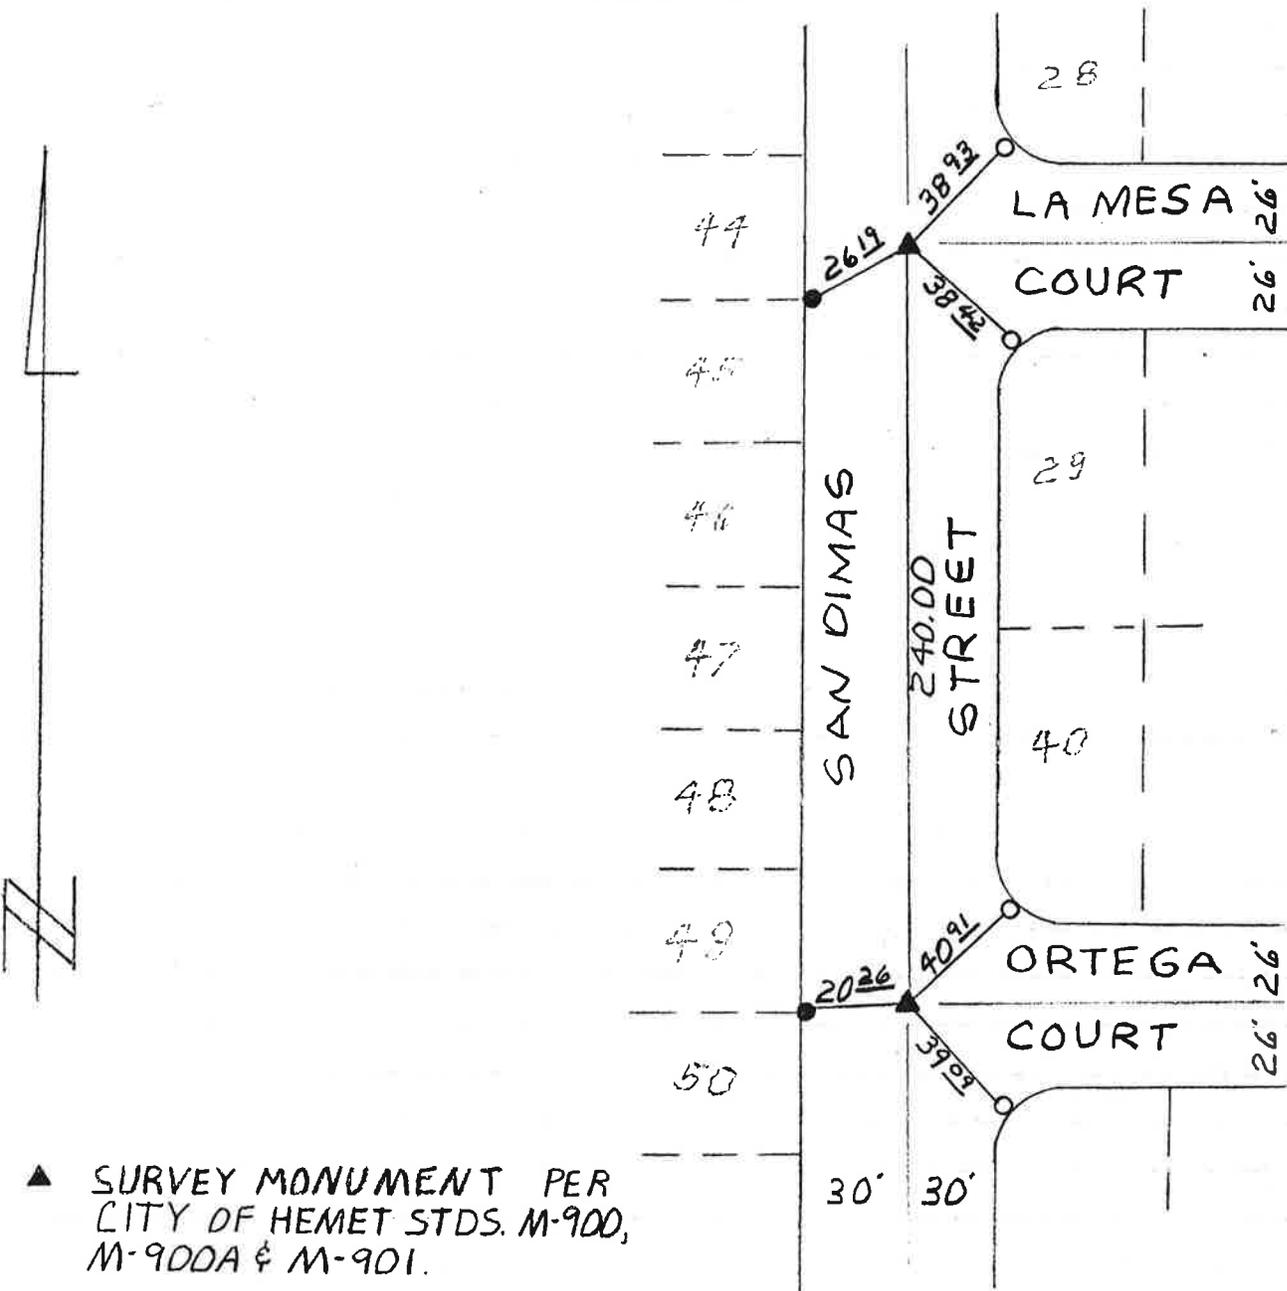


- ▲ SURVEY MONUMENT PER CITY OF HEMET STDS. M-900, M-900A & M-901.
- NAIL & TAG RCE 26406 OR LEAD & TACK IN TOP OF CURB.
- CONCRETE NAIL IN TOP OF CURB.

11/90

MONUMENT TIES

SECTION 9 TOWNSHIP 5S RANGE 1W

TRACT NO. 14871-1

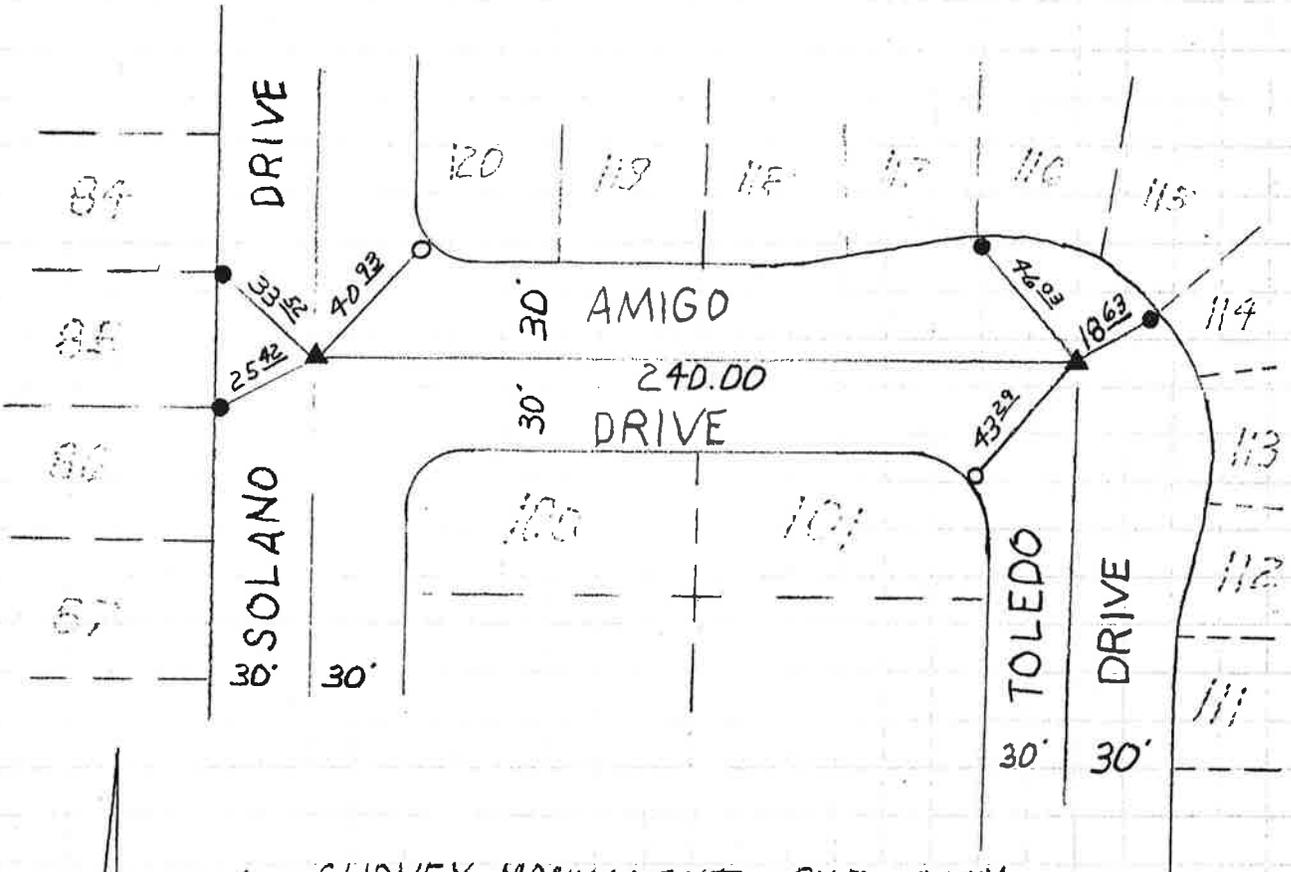

- ▲ SURVEY MONUMENT PER CITY OF HEMET STDS. M-900, M-900A & M-901.
- NAIL & TAG RCE 14232 OR LEAD & TACK IN TOP OF CURB.
- CONCRETE NAIL IN TOP OF CURB.


11/90

City of Hemet
450 E. Latham Ave., Hemet, CA 92343

MONUMENT TIES

SECTION 9 TOWNSHIP 5S RANGE 1W

TRACT NO. 14871-1

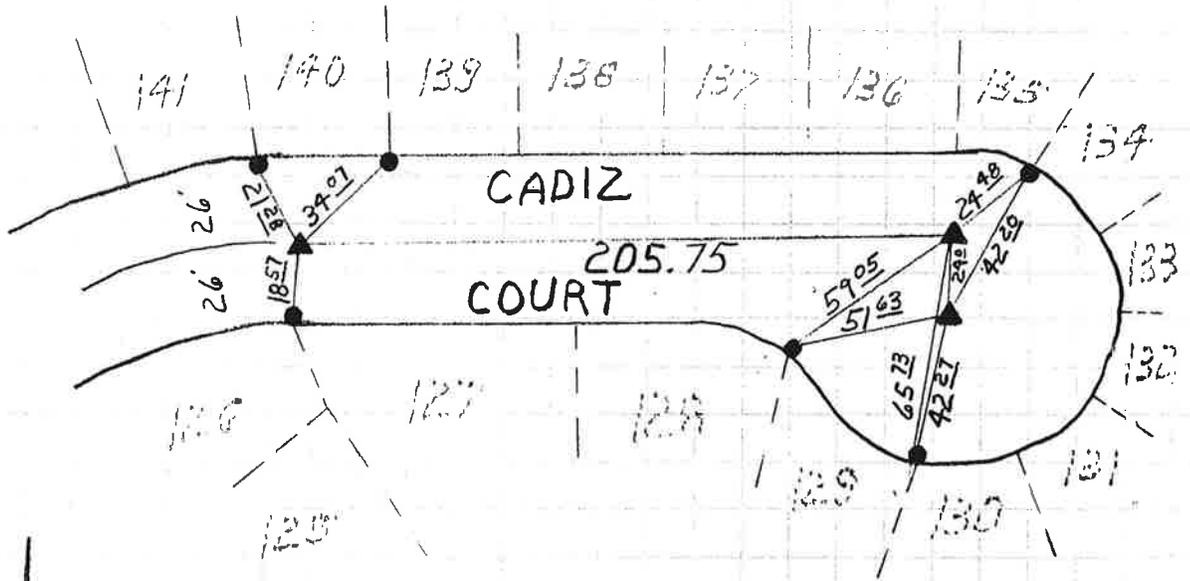


- ▲ SURVEY MONUMENT PER CITY OF HEMET STDS. M-900, M-900A & M-901.
- NAIL & TAG RCE 14232 OR LEAD & TACK IN TOP OF CURB.
- CONCRETE NAIL IN TOP OF CURB.

11/90

FRH 6/28/66

Ties to Latham Ave. & Palm Ave.
Dist. 64-2

SHEET NO. OF
JOB NO 59-067-002-16

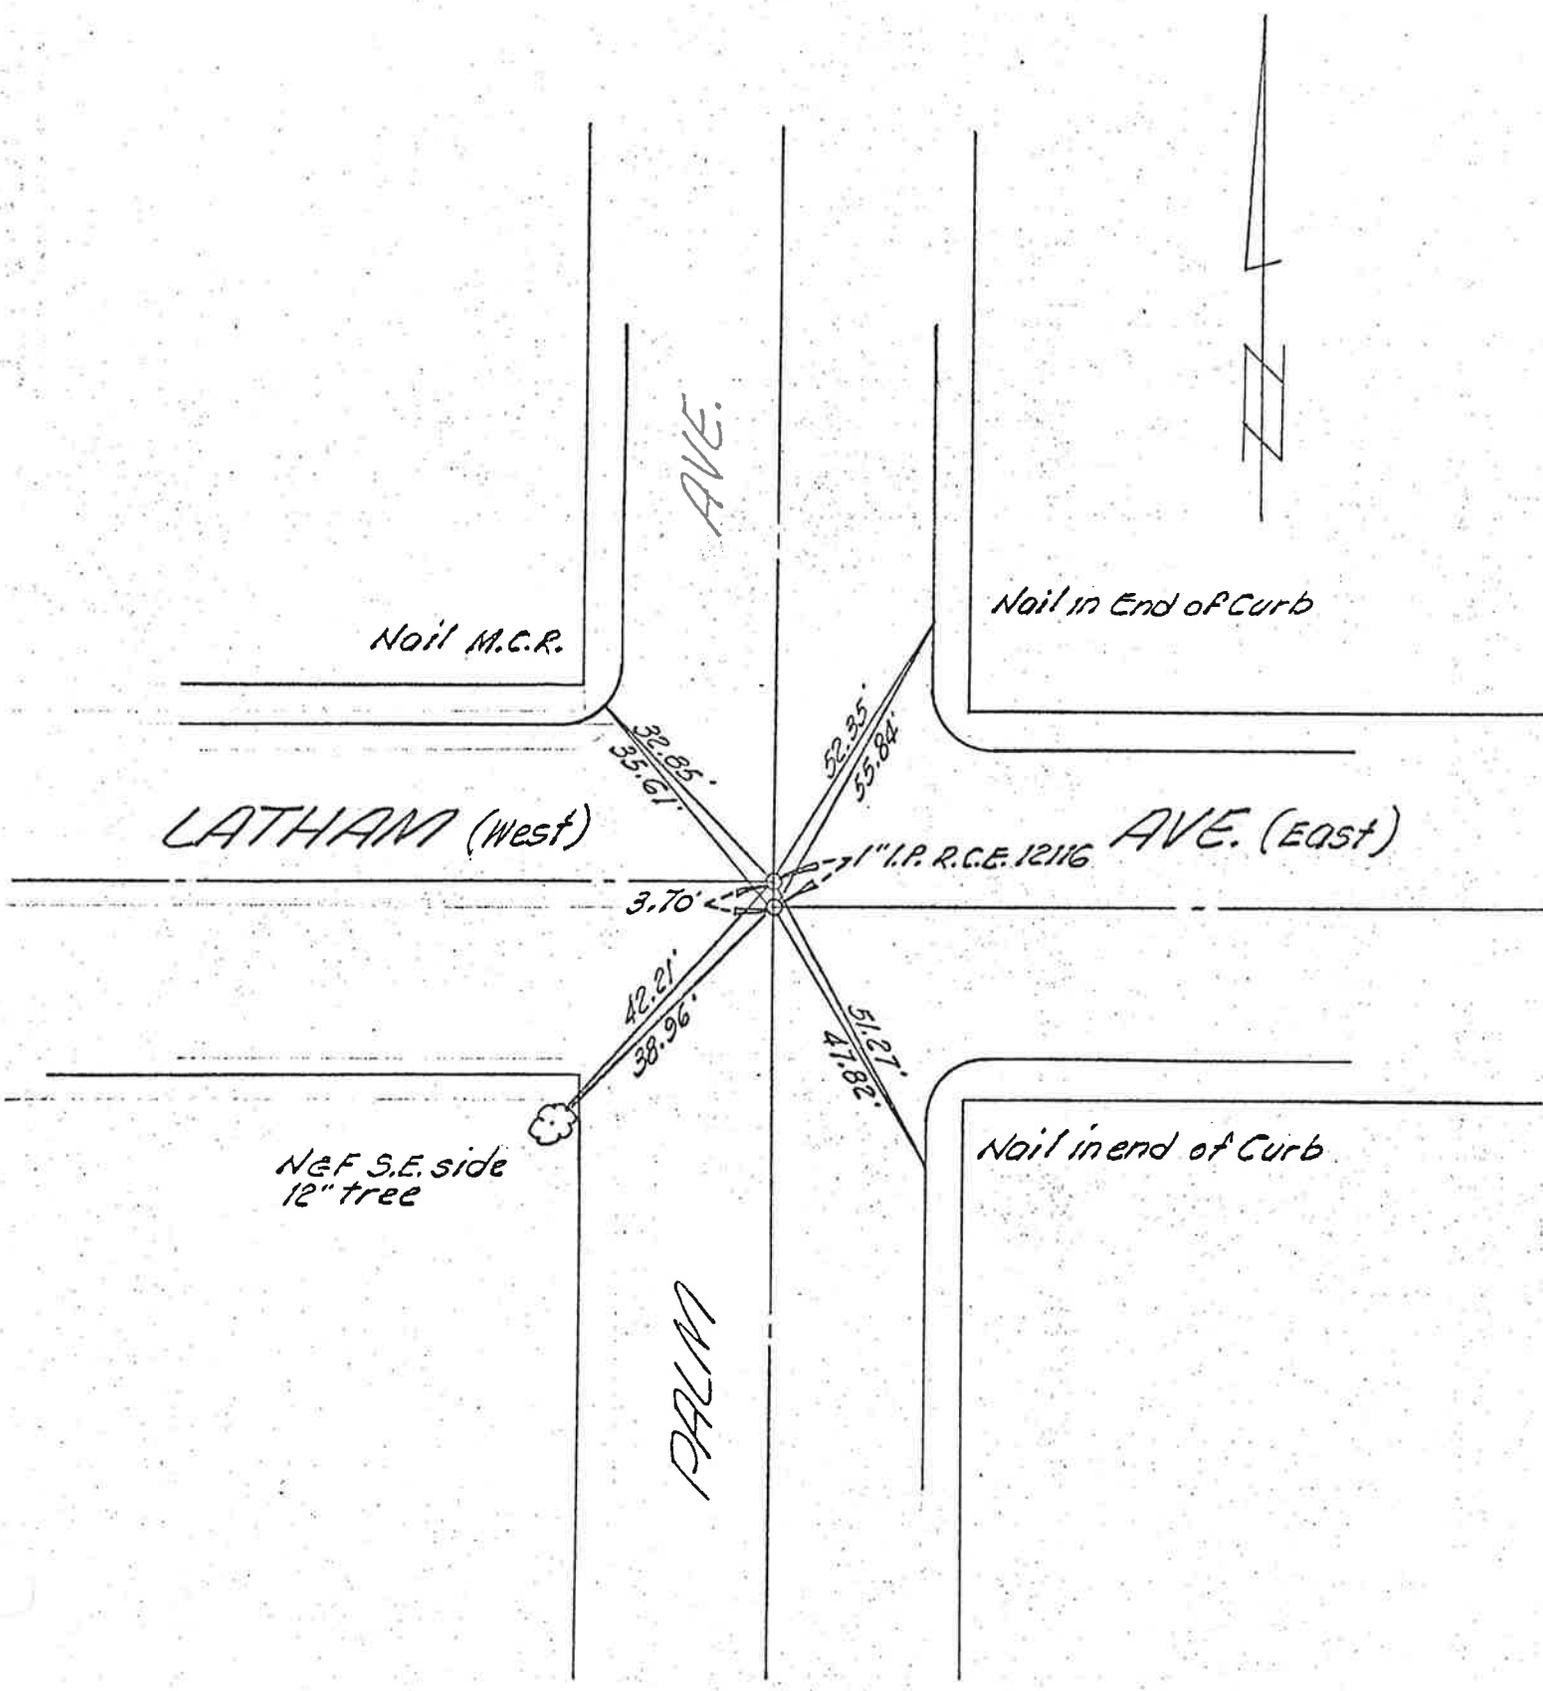

BY ERH DATE 6/20/66


SUBJECT Ties to Devonshire Av.

SHEET NO. 102 NO. 59-067-002-16

BY DATE

E. Palm Ave.

Dist. 6A-2

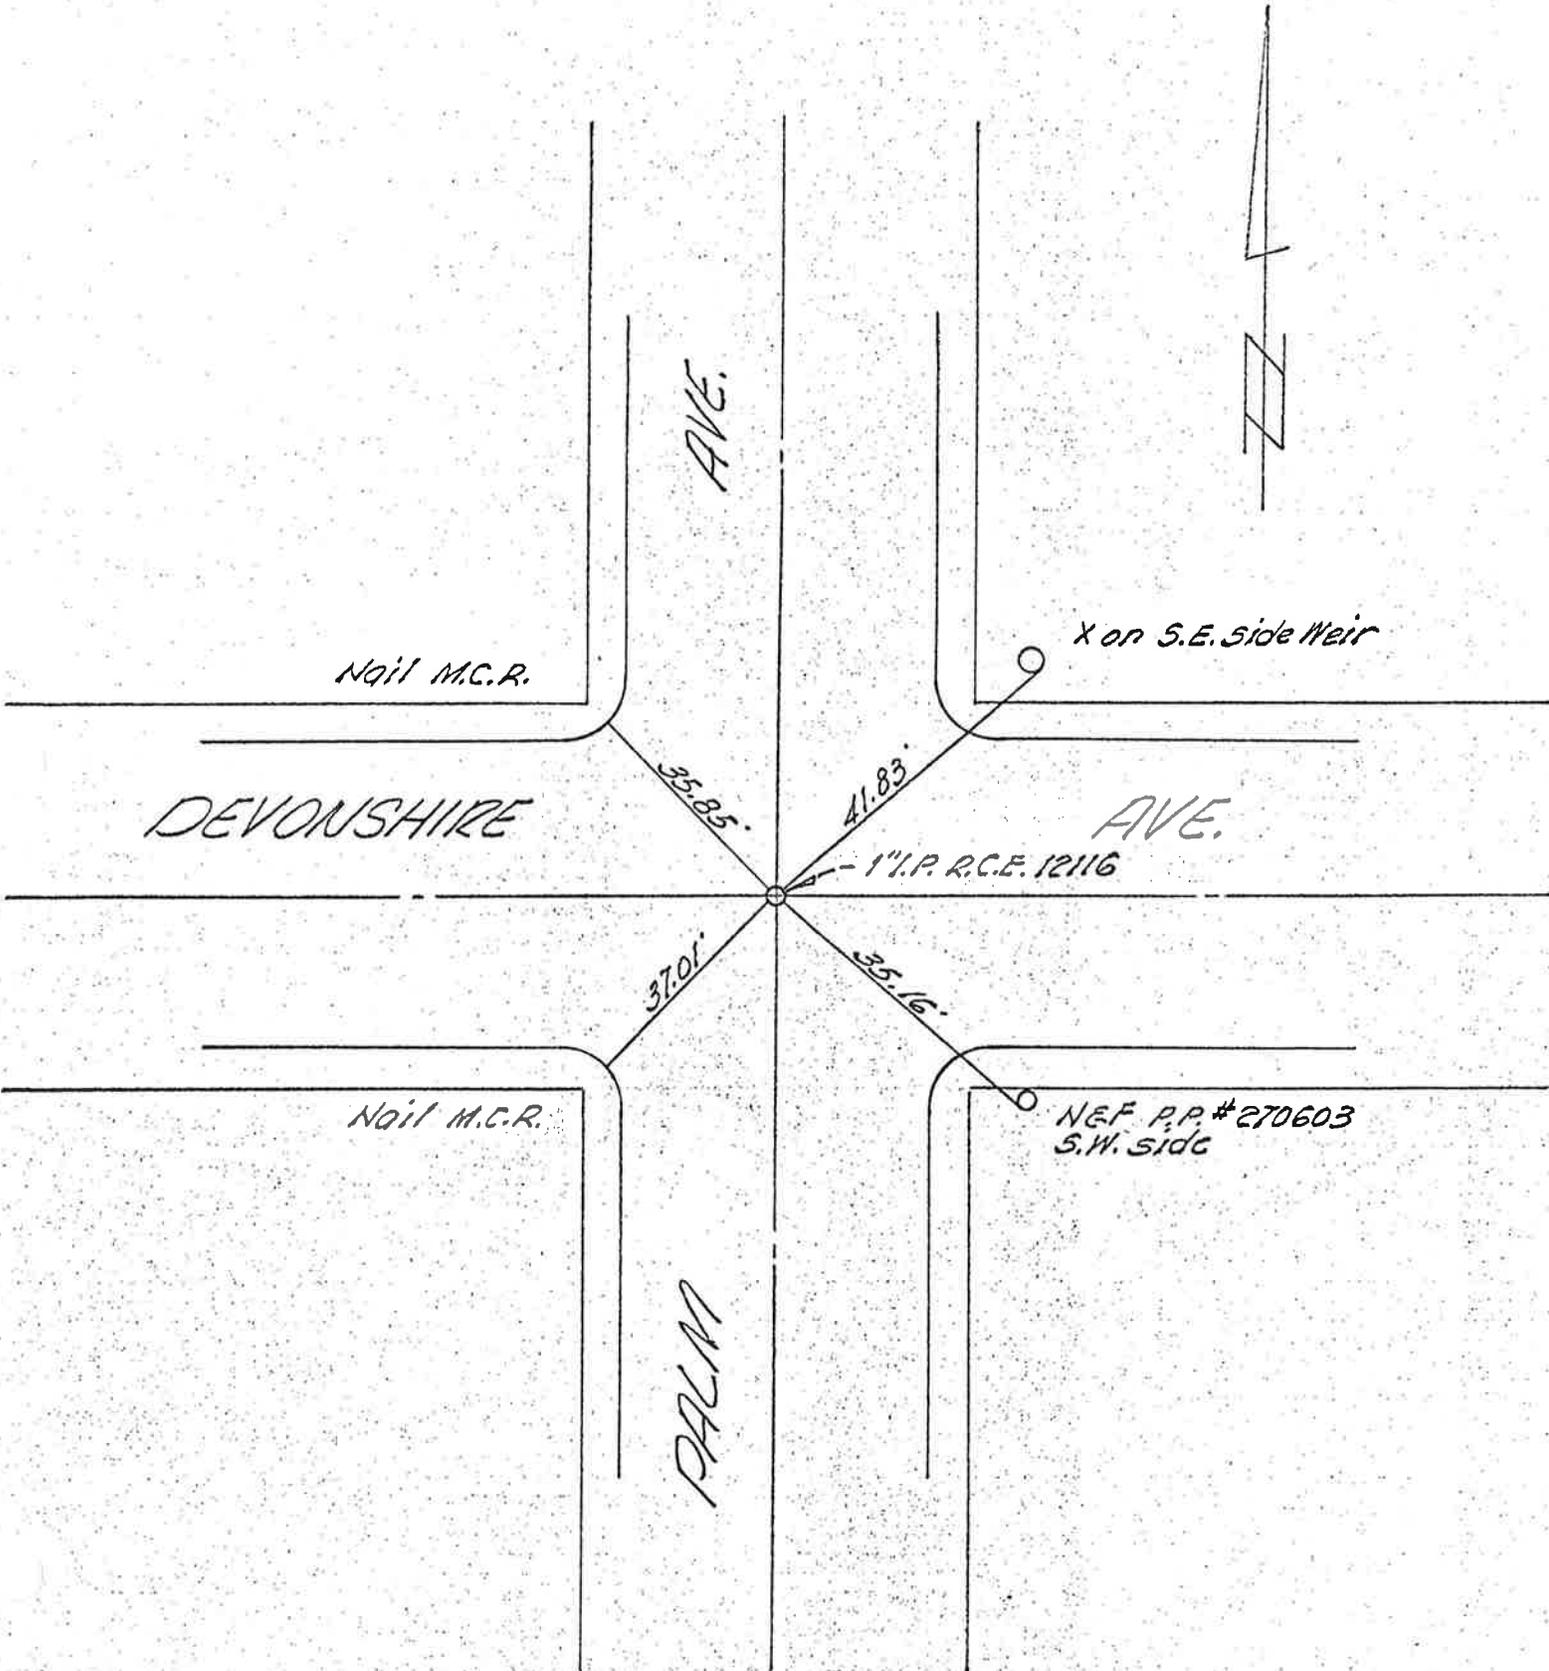

BY FRH

DATE 6/28/66

LOC. Ties to Devonshire Av E

SHEET NO. 111


CHKD. BY

DATE


LYON Ave.

JOB NO. 59-067-002-16

Dist. 64-2

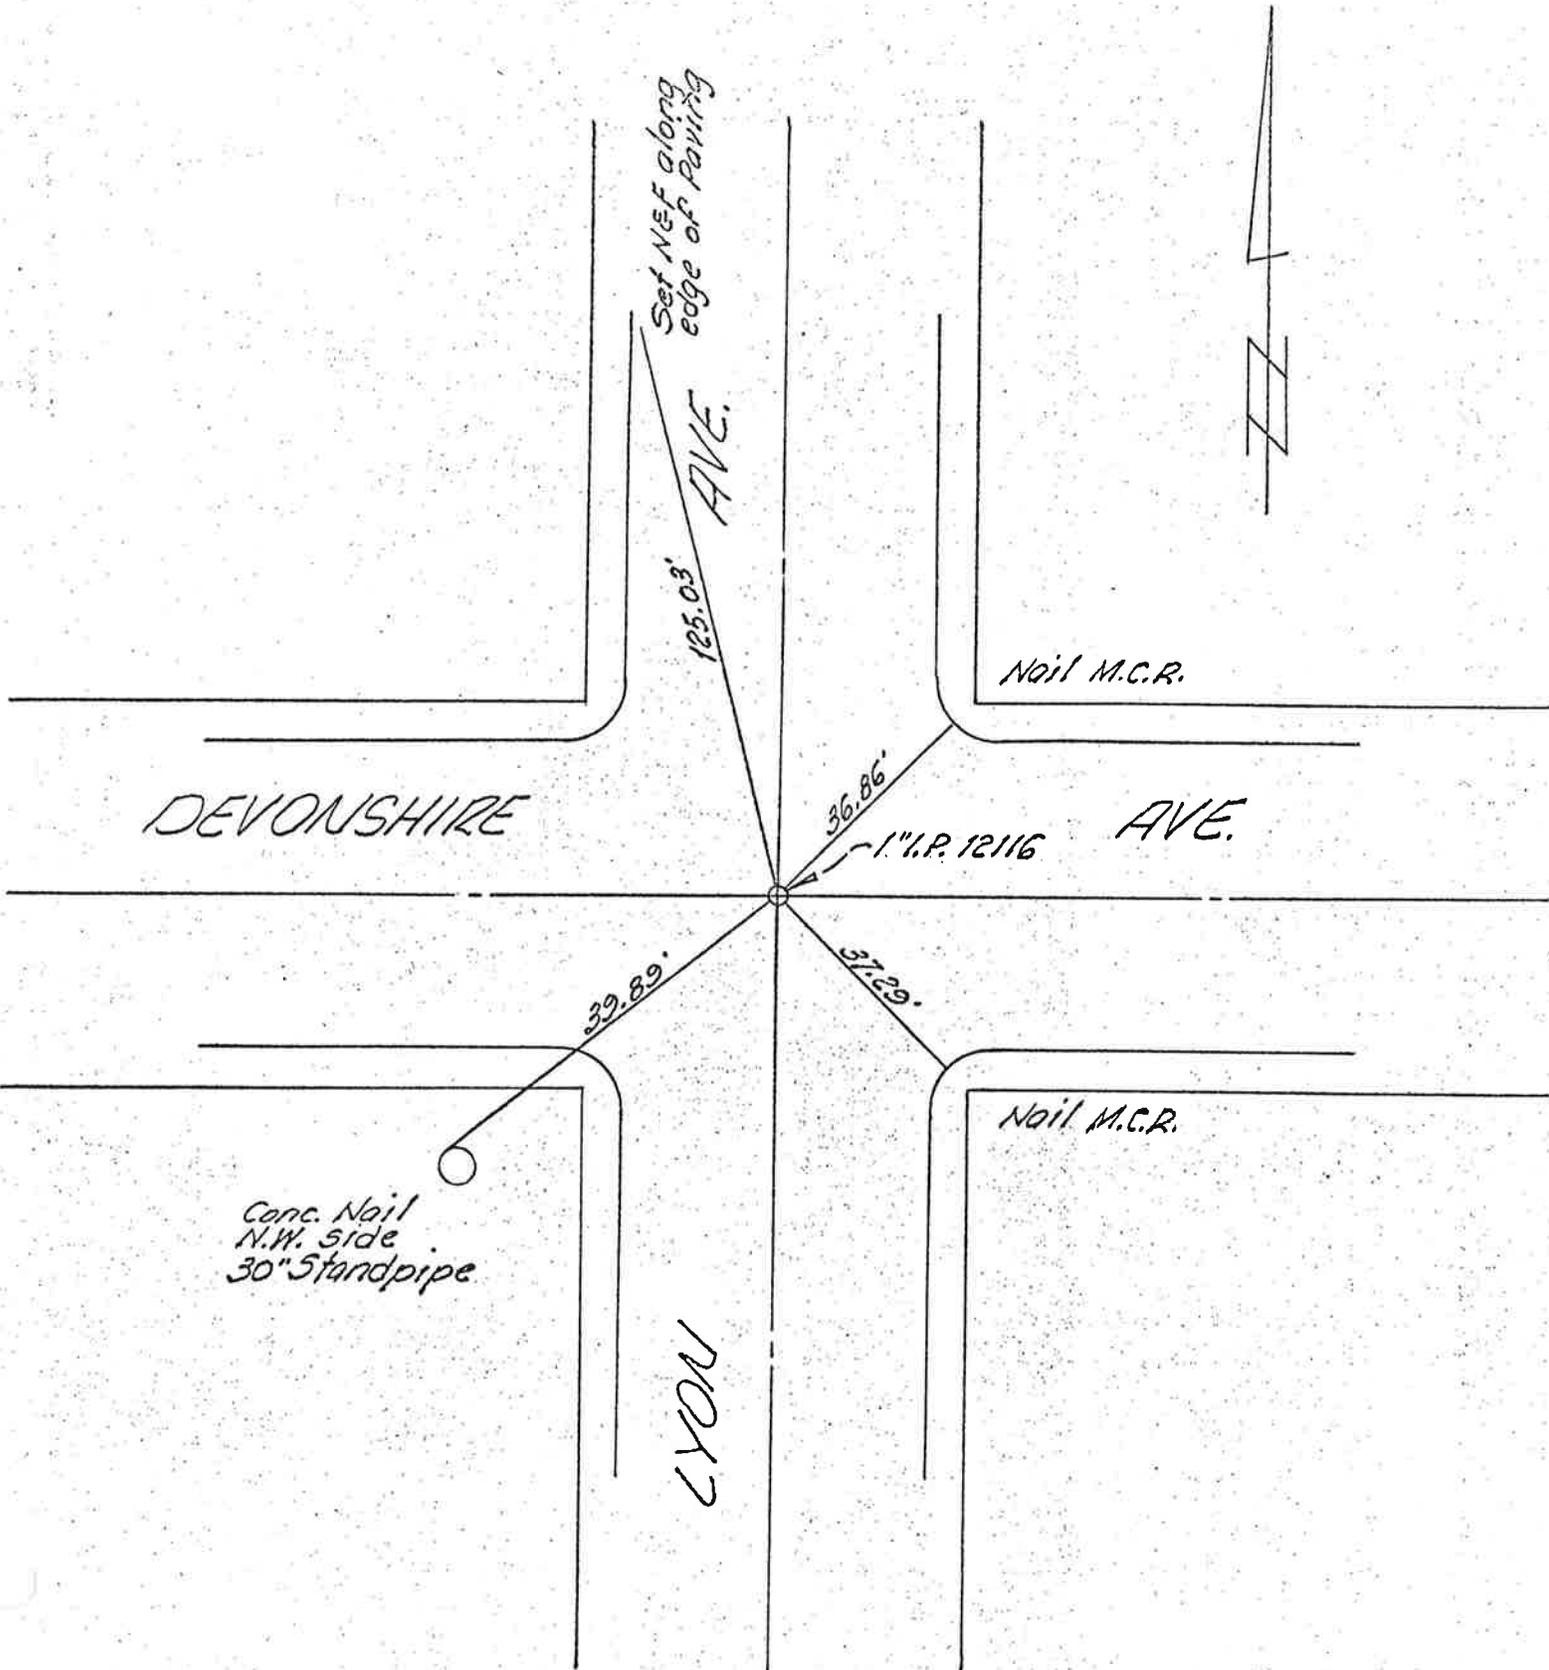


BY *FRH* DATE *6/24/66* WEST *Ties to Devonshire & Hamilton Ave.* SHEET NO. _____
CHG. BY _____ DATE _____ DIST. *64-2* JOB NO. *59-067-002-16*

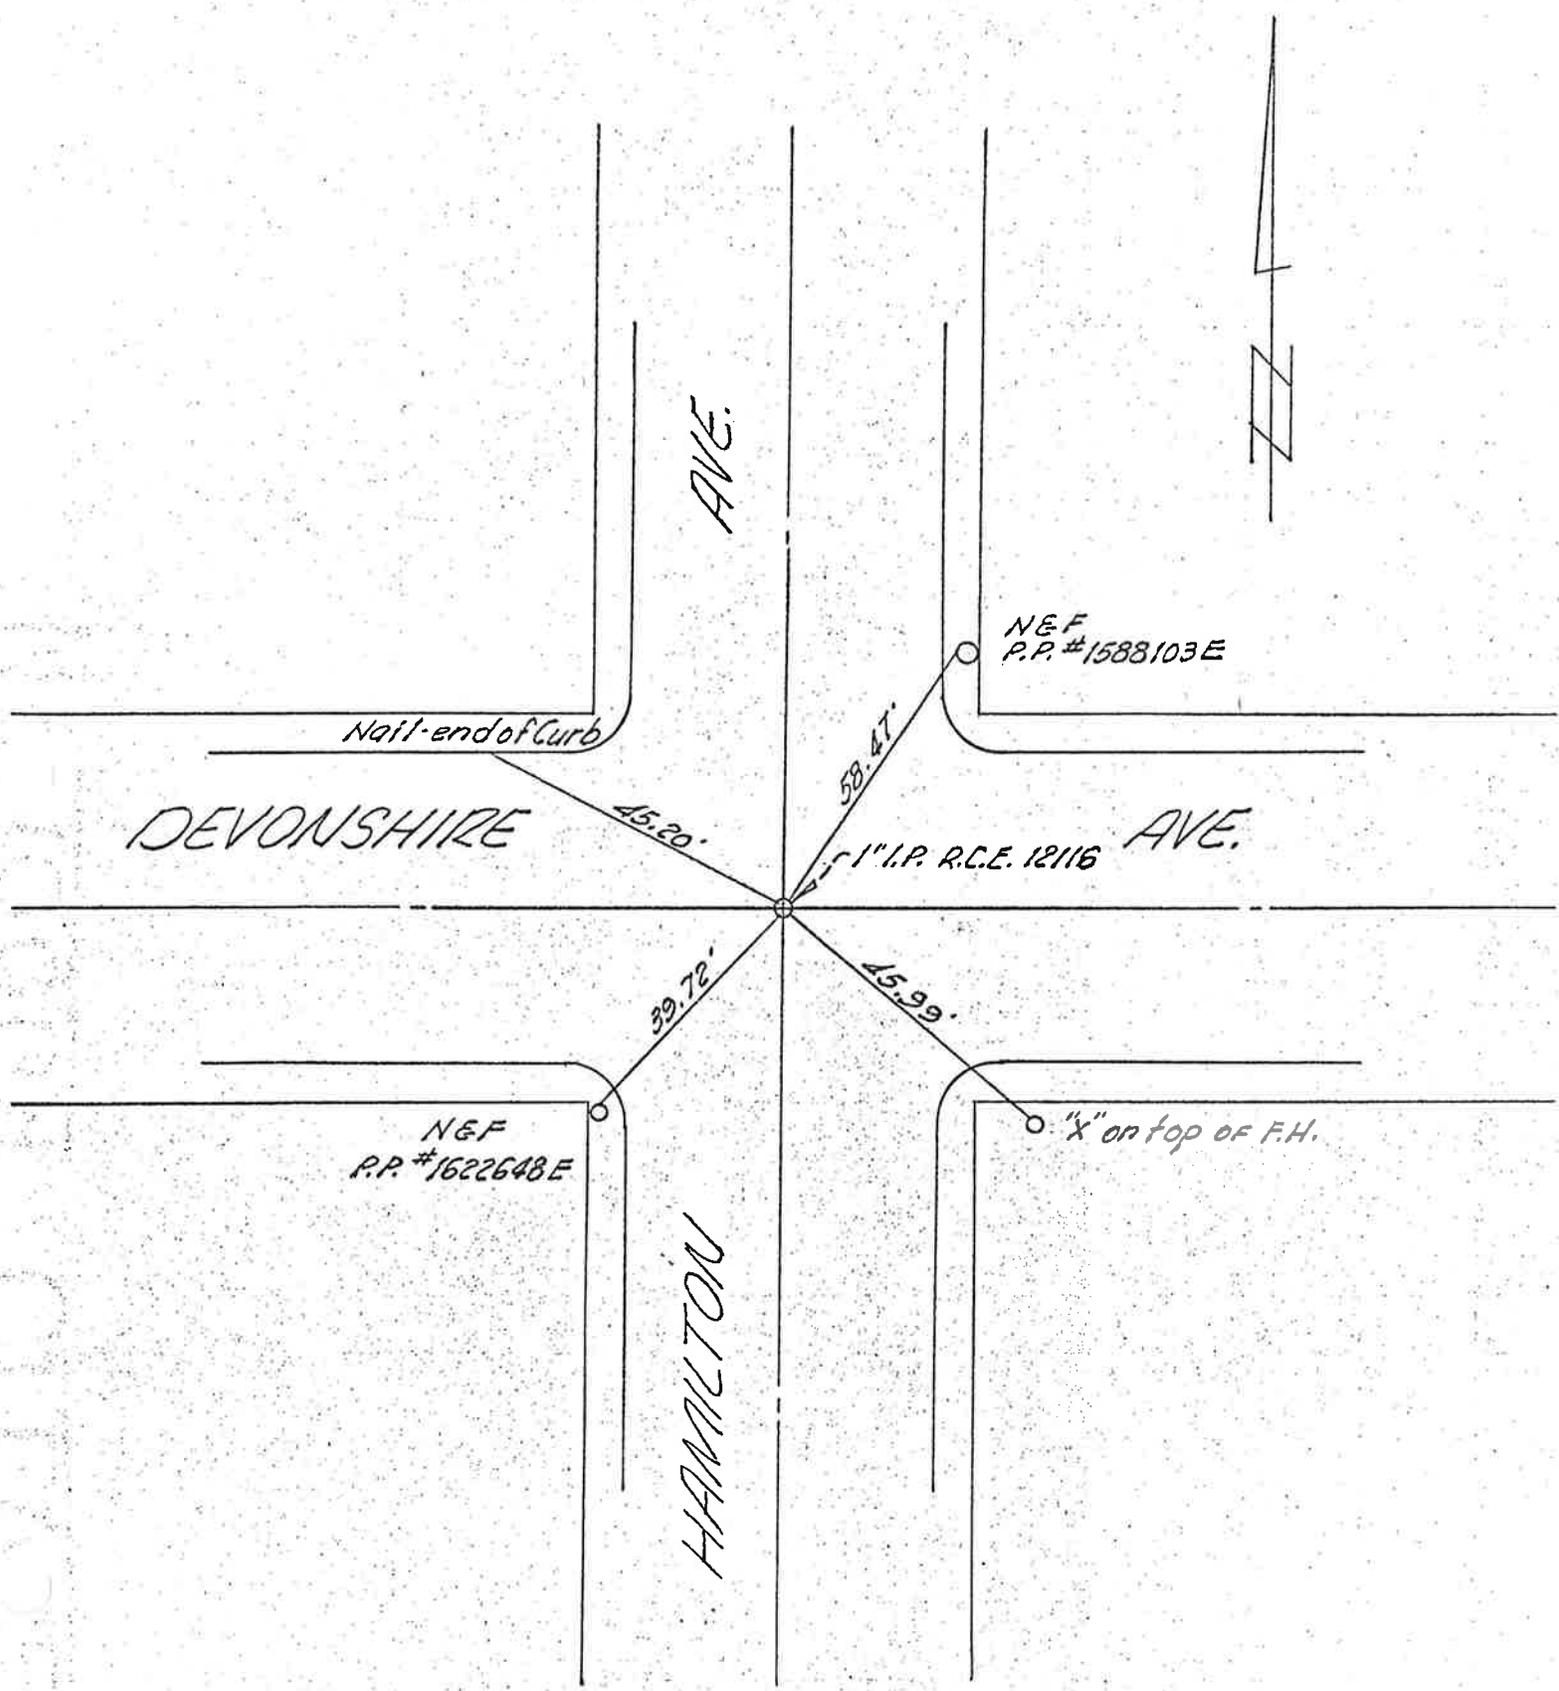

BY FRH DATE 6/23/06

Ties to Devonshire Ave of
Western Ave.
Dist 64-2


PROJECT NO. 59-067-002-16

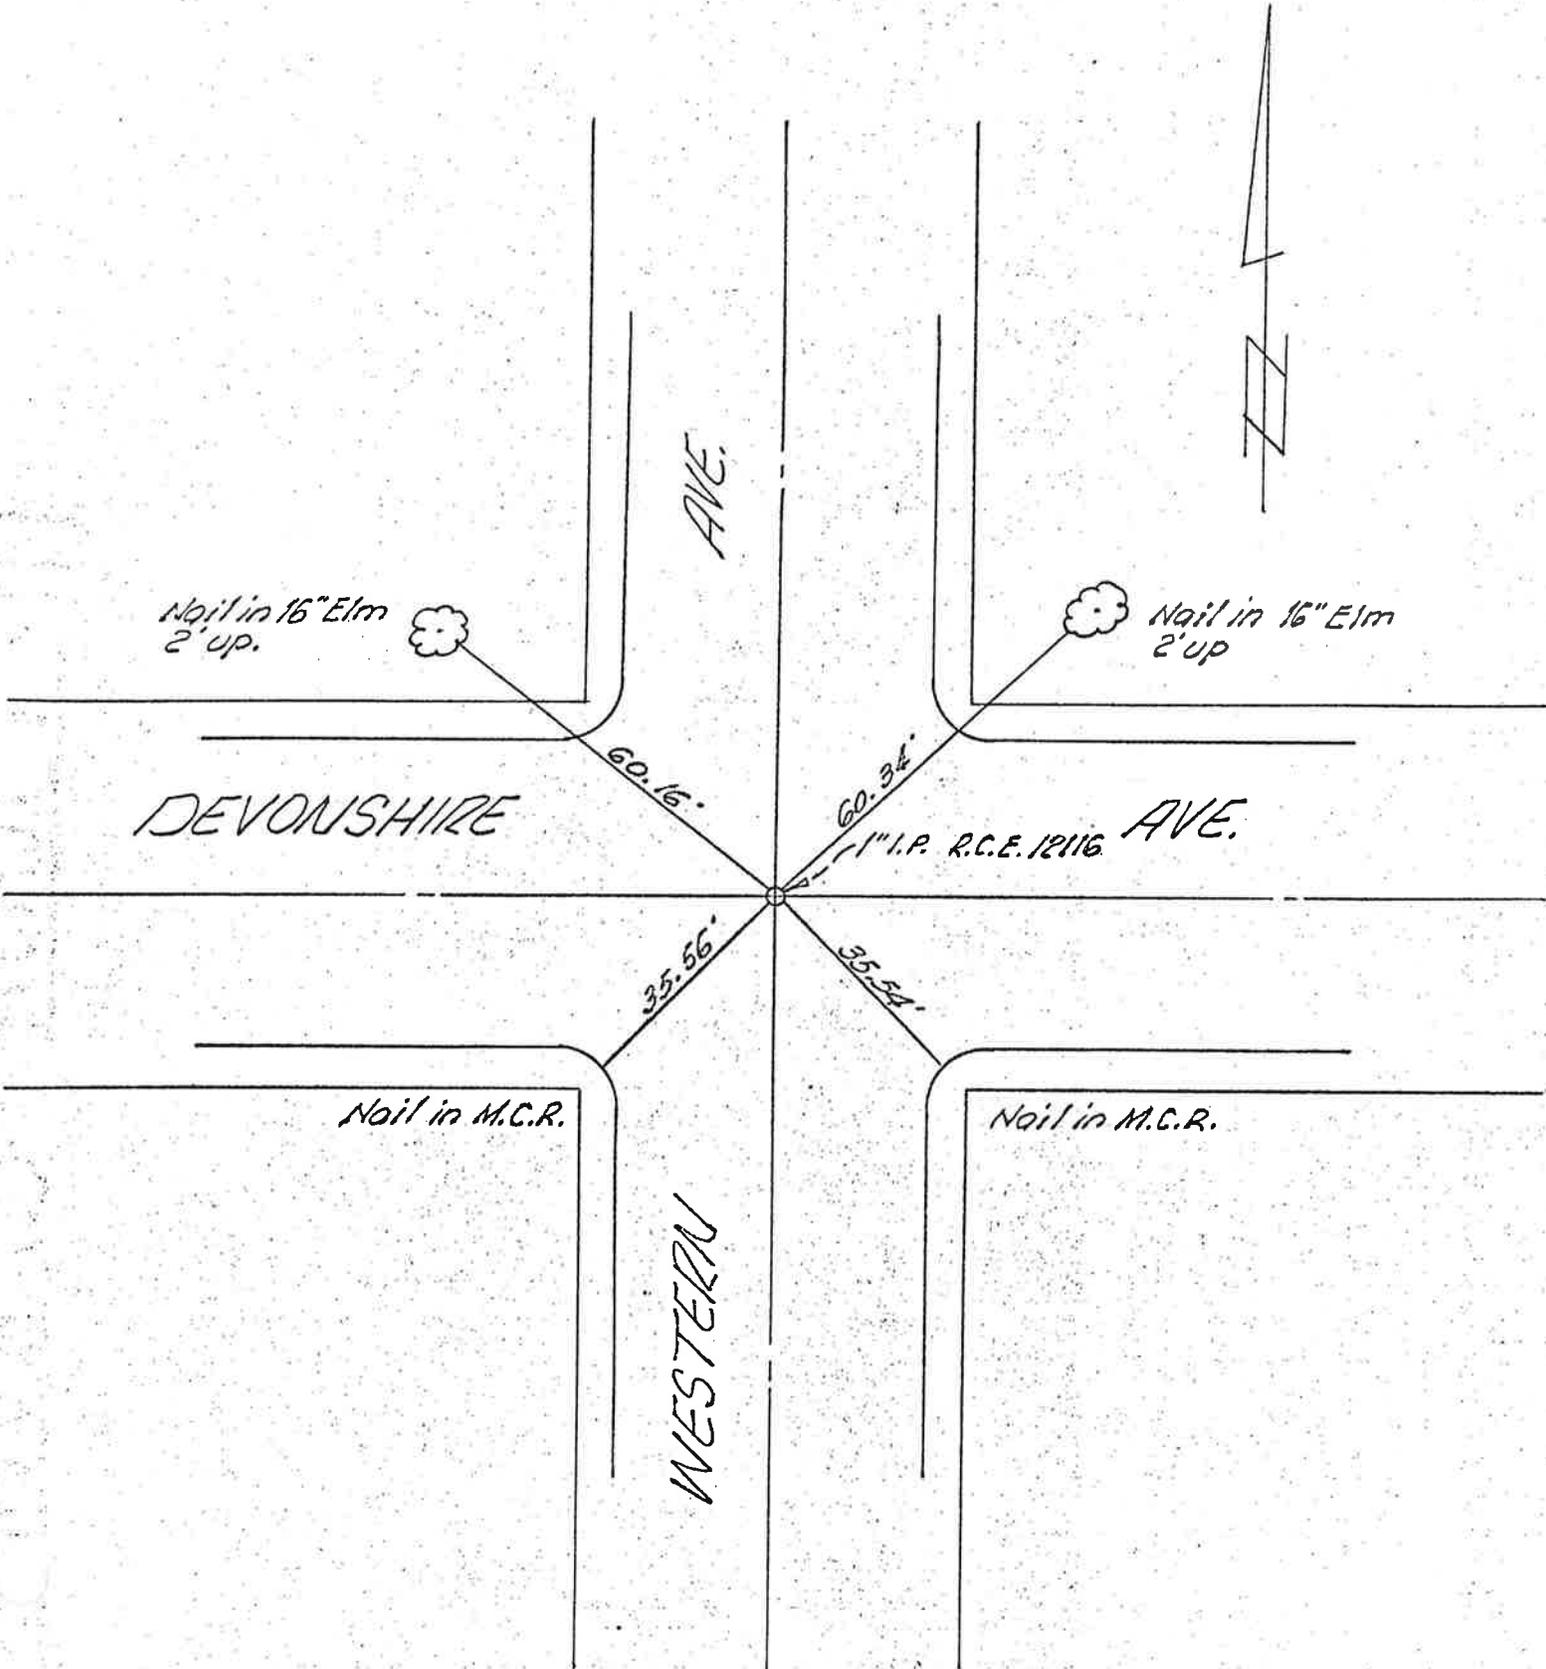

BY *FRH* DATE *6/28/66*

PROJECT *Ties to Devonshire Ave.
Valleyview Dr.
Dist. 64-2*

SHEET NO. _____ OF _____
JOB NO. *59-067-002-16*

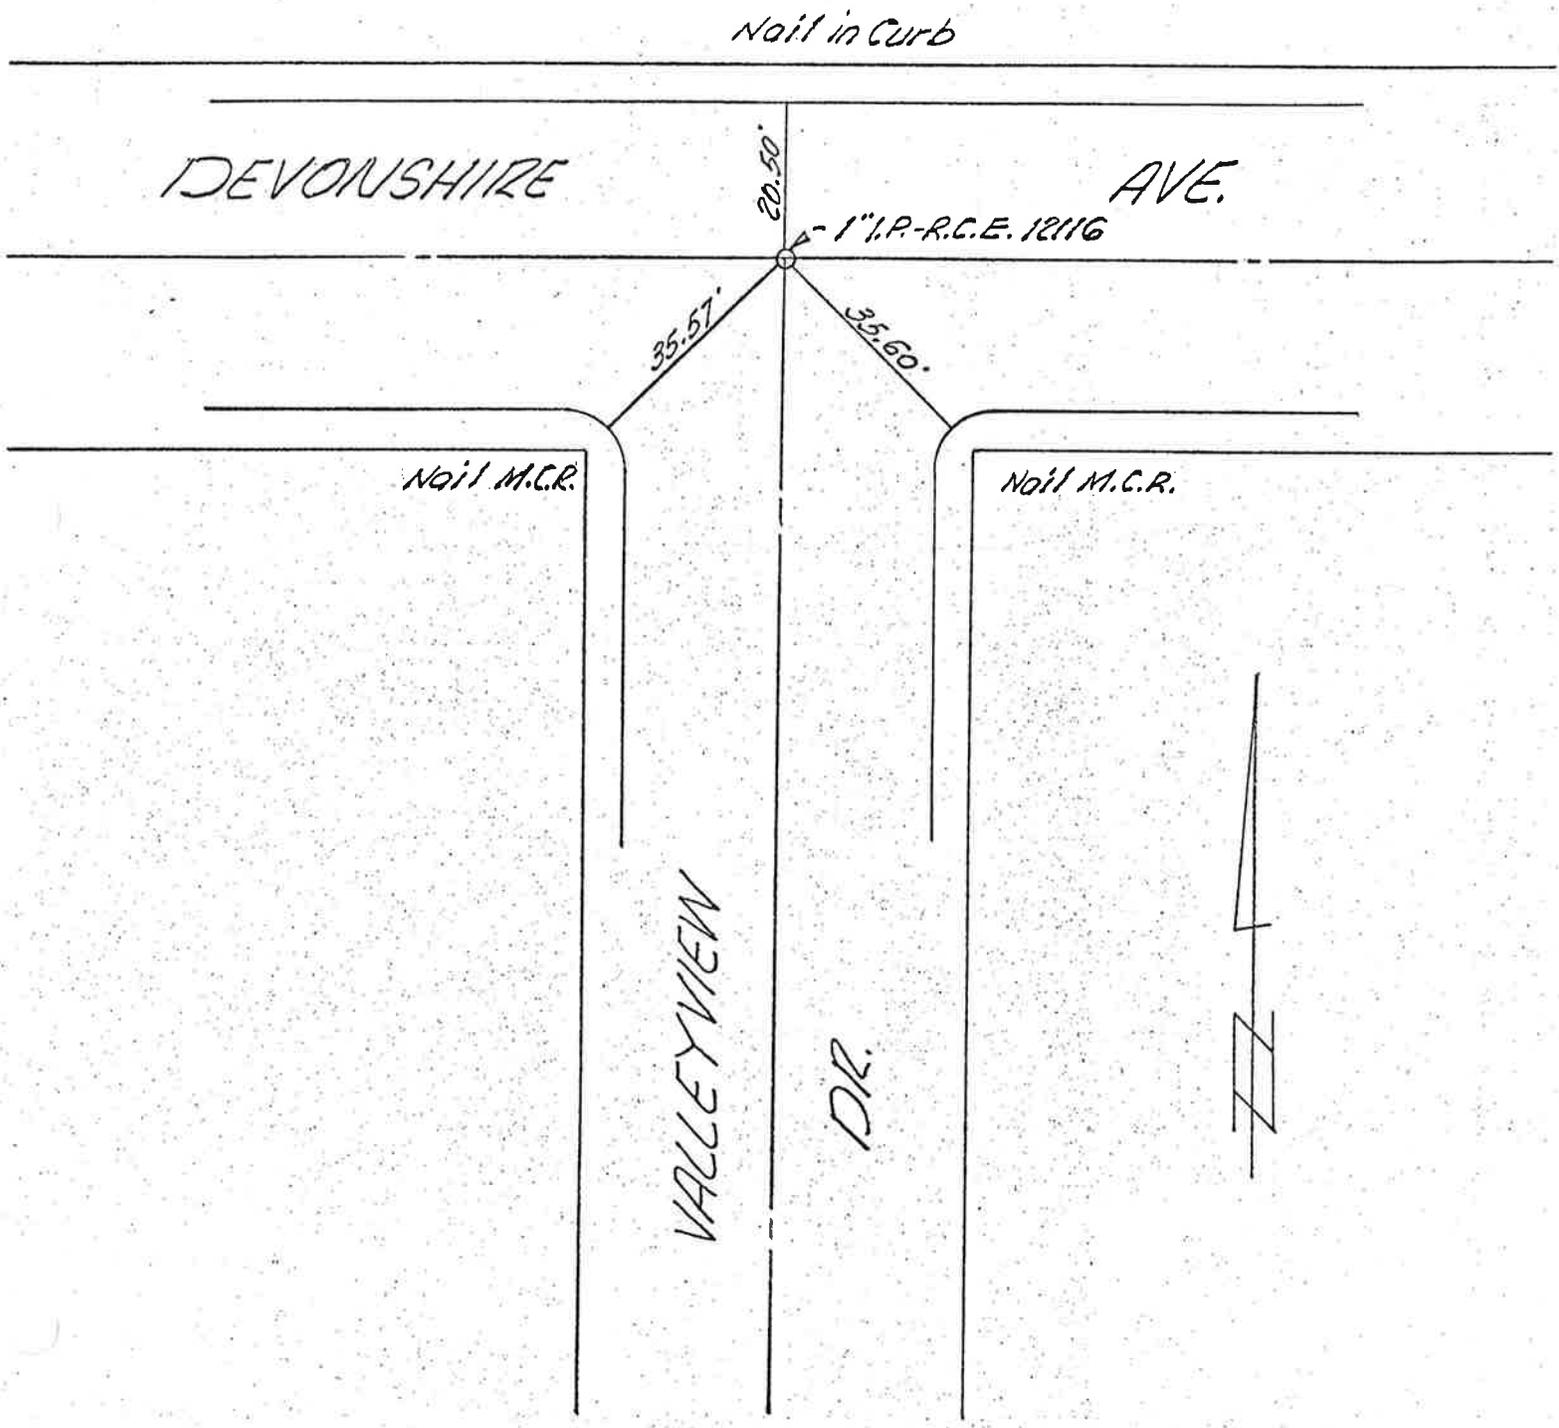

FRH

DATE 6/28/65

TIES TO DEVONSHIRE AVE.


CREATED BY

DATE


ELK ST.

59-067-002-16

DIST. 64-2

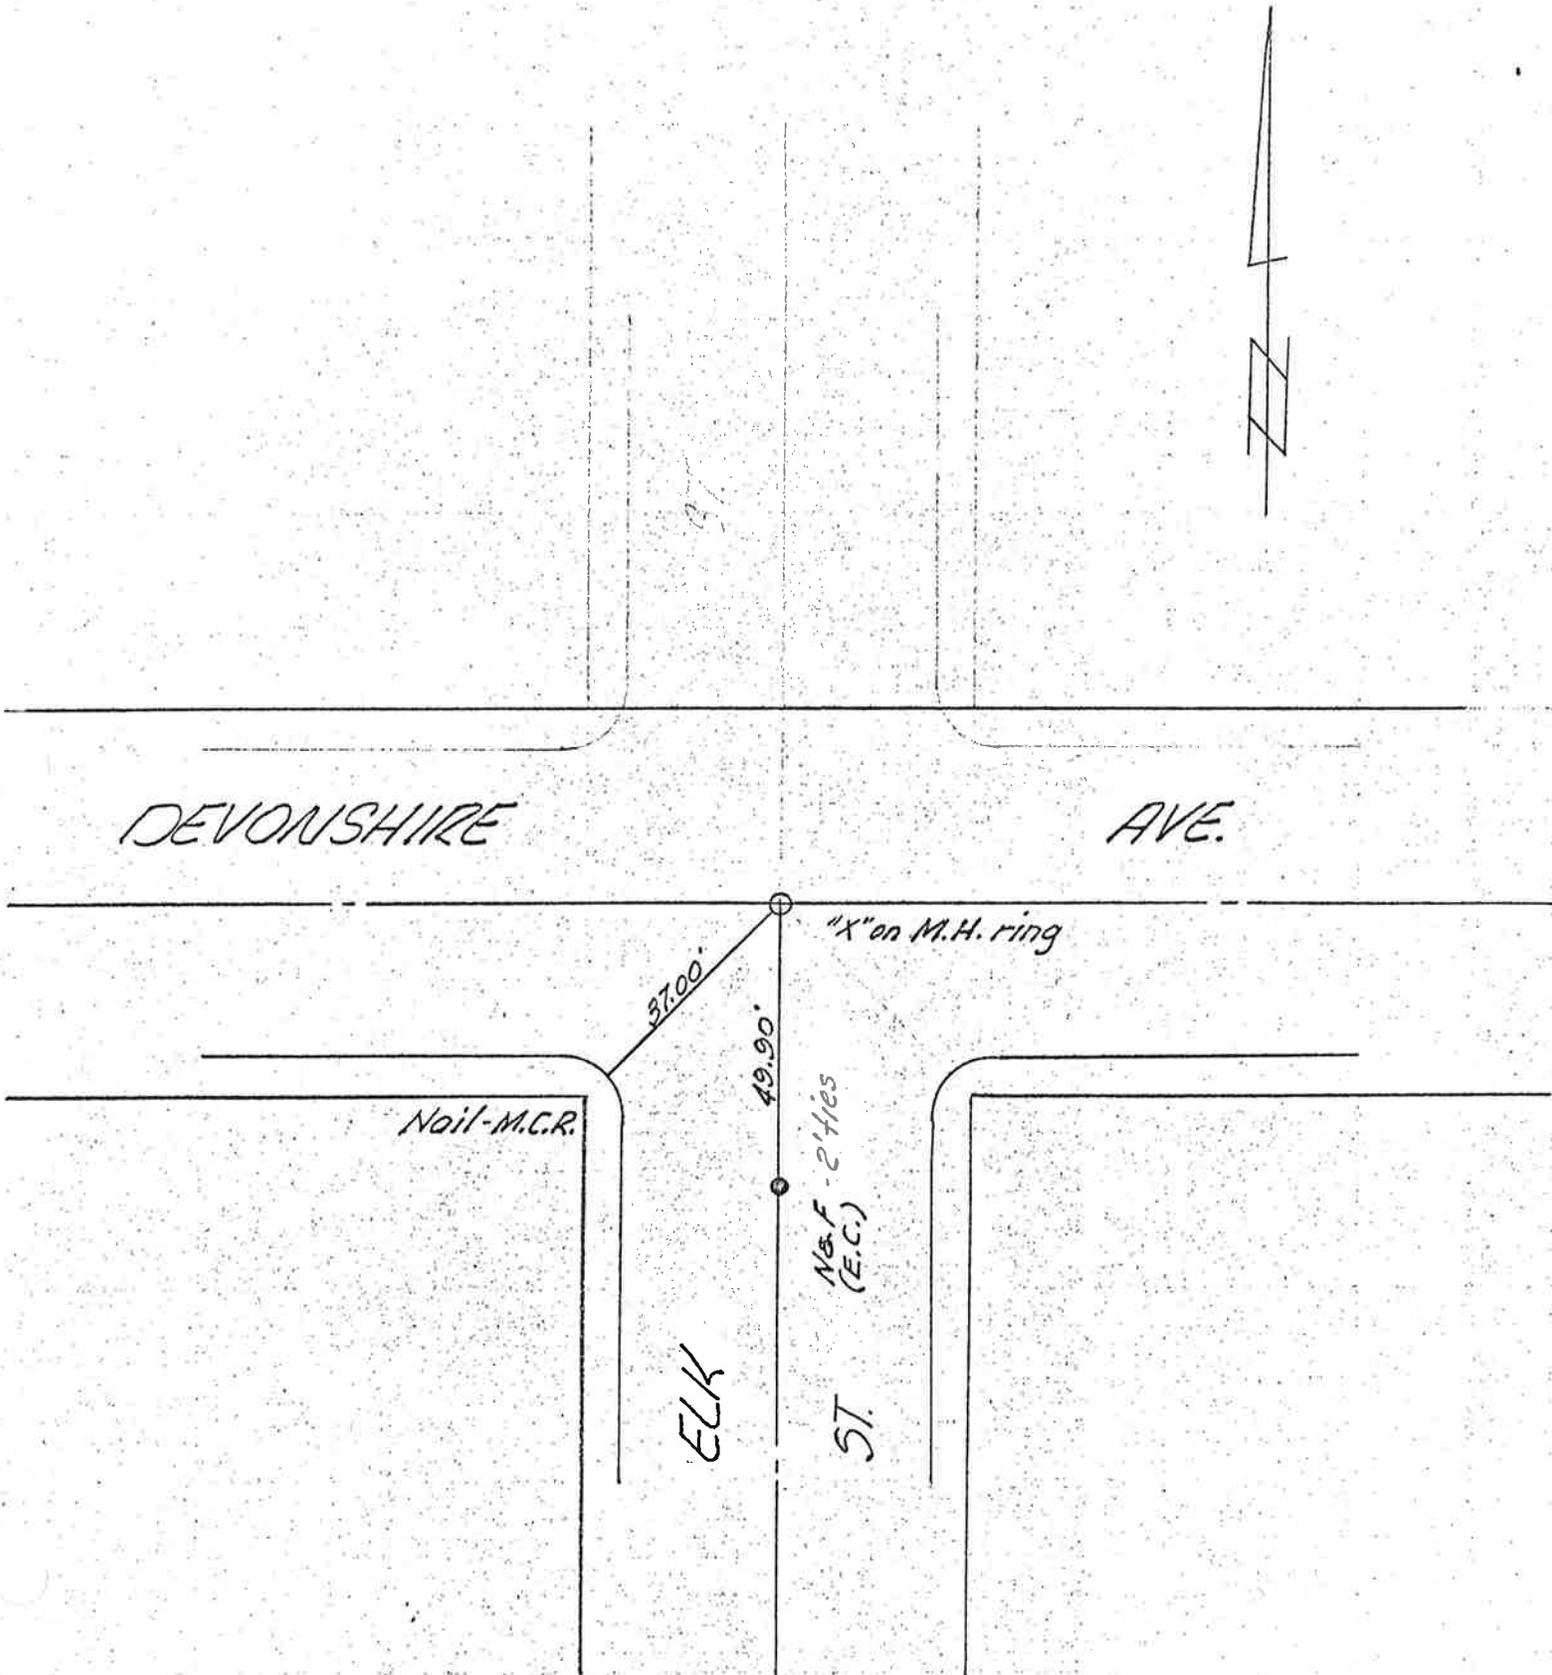


FRH 6/28/66 SUBJECT Ties to Latham Ave. f
ELK ST.
Dist. 64-2
DATE 6/28/66
FILE NO. 59-067-002-16

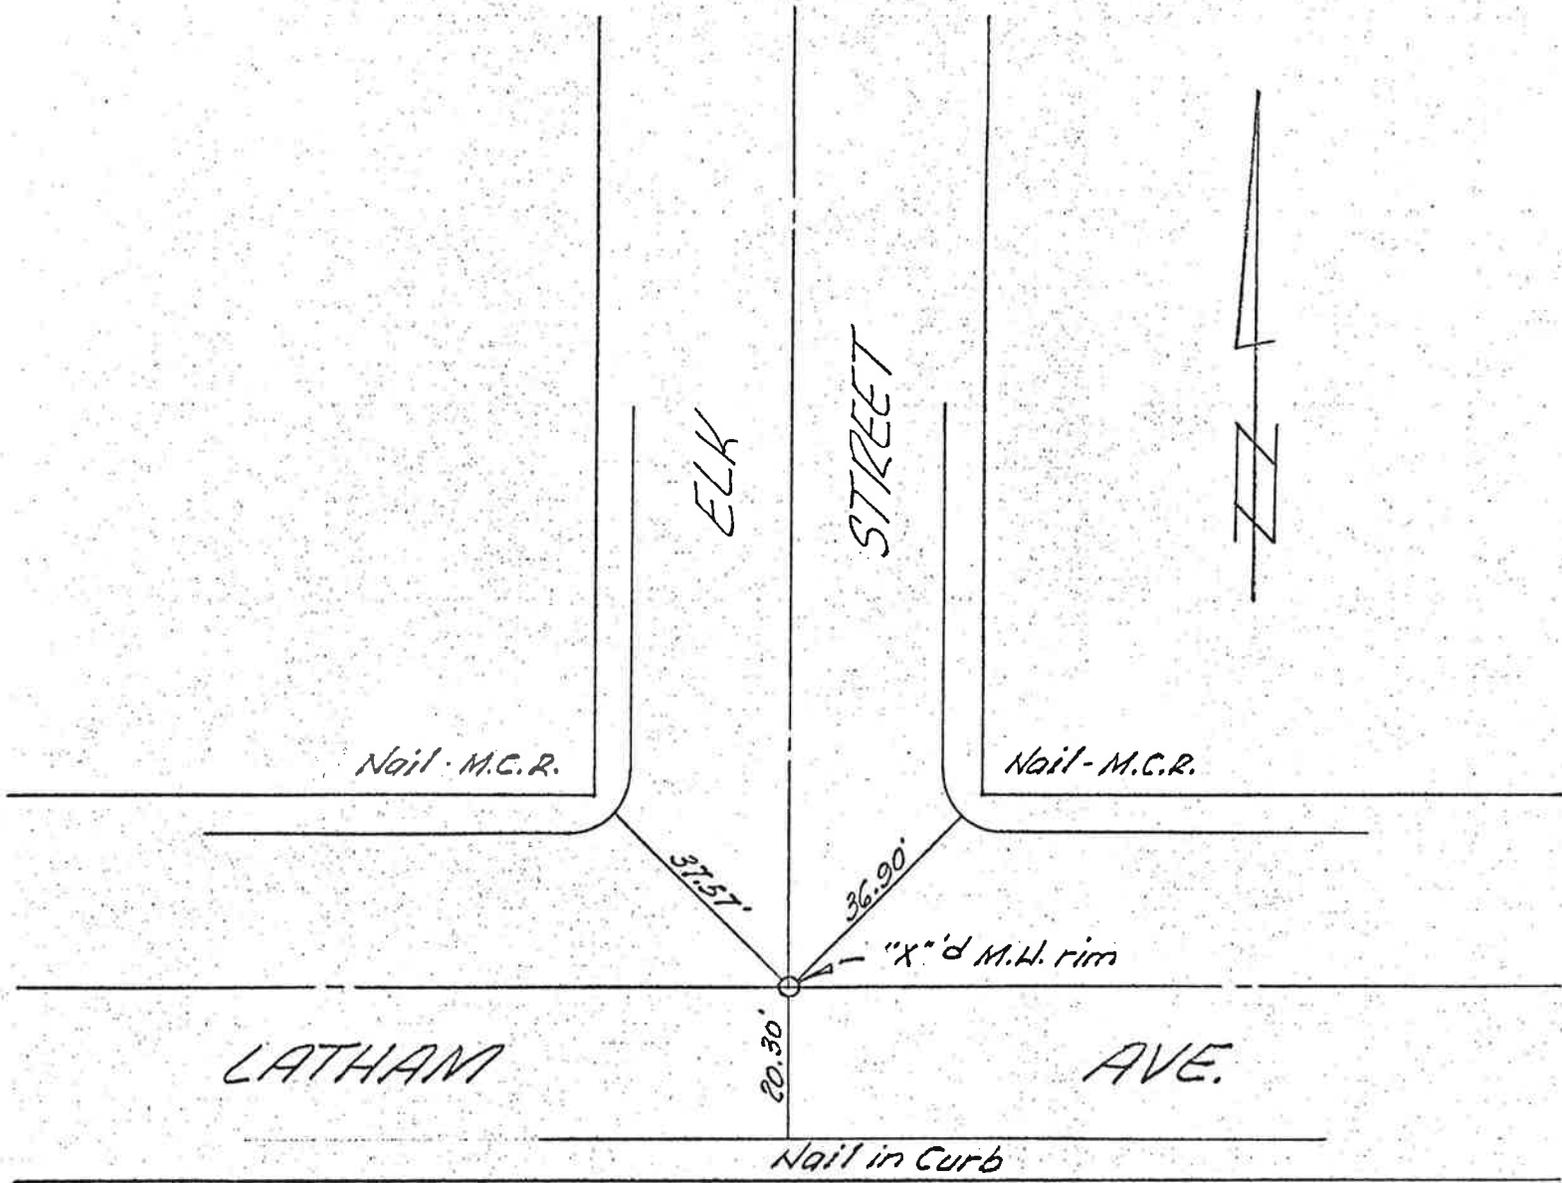

BY *FRH* DATE *6/28/66*
CHECKED BY DATE

Ties to Latham Ave. E.
Valleyview Dr.
Dist. 64-2

SHEET NO. OF
JOB NO. *59-067-002-16*

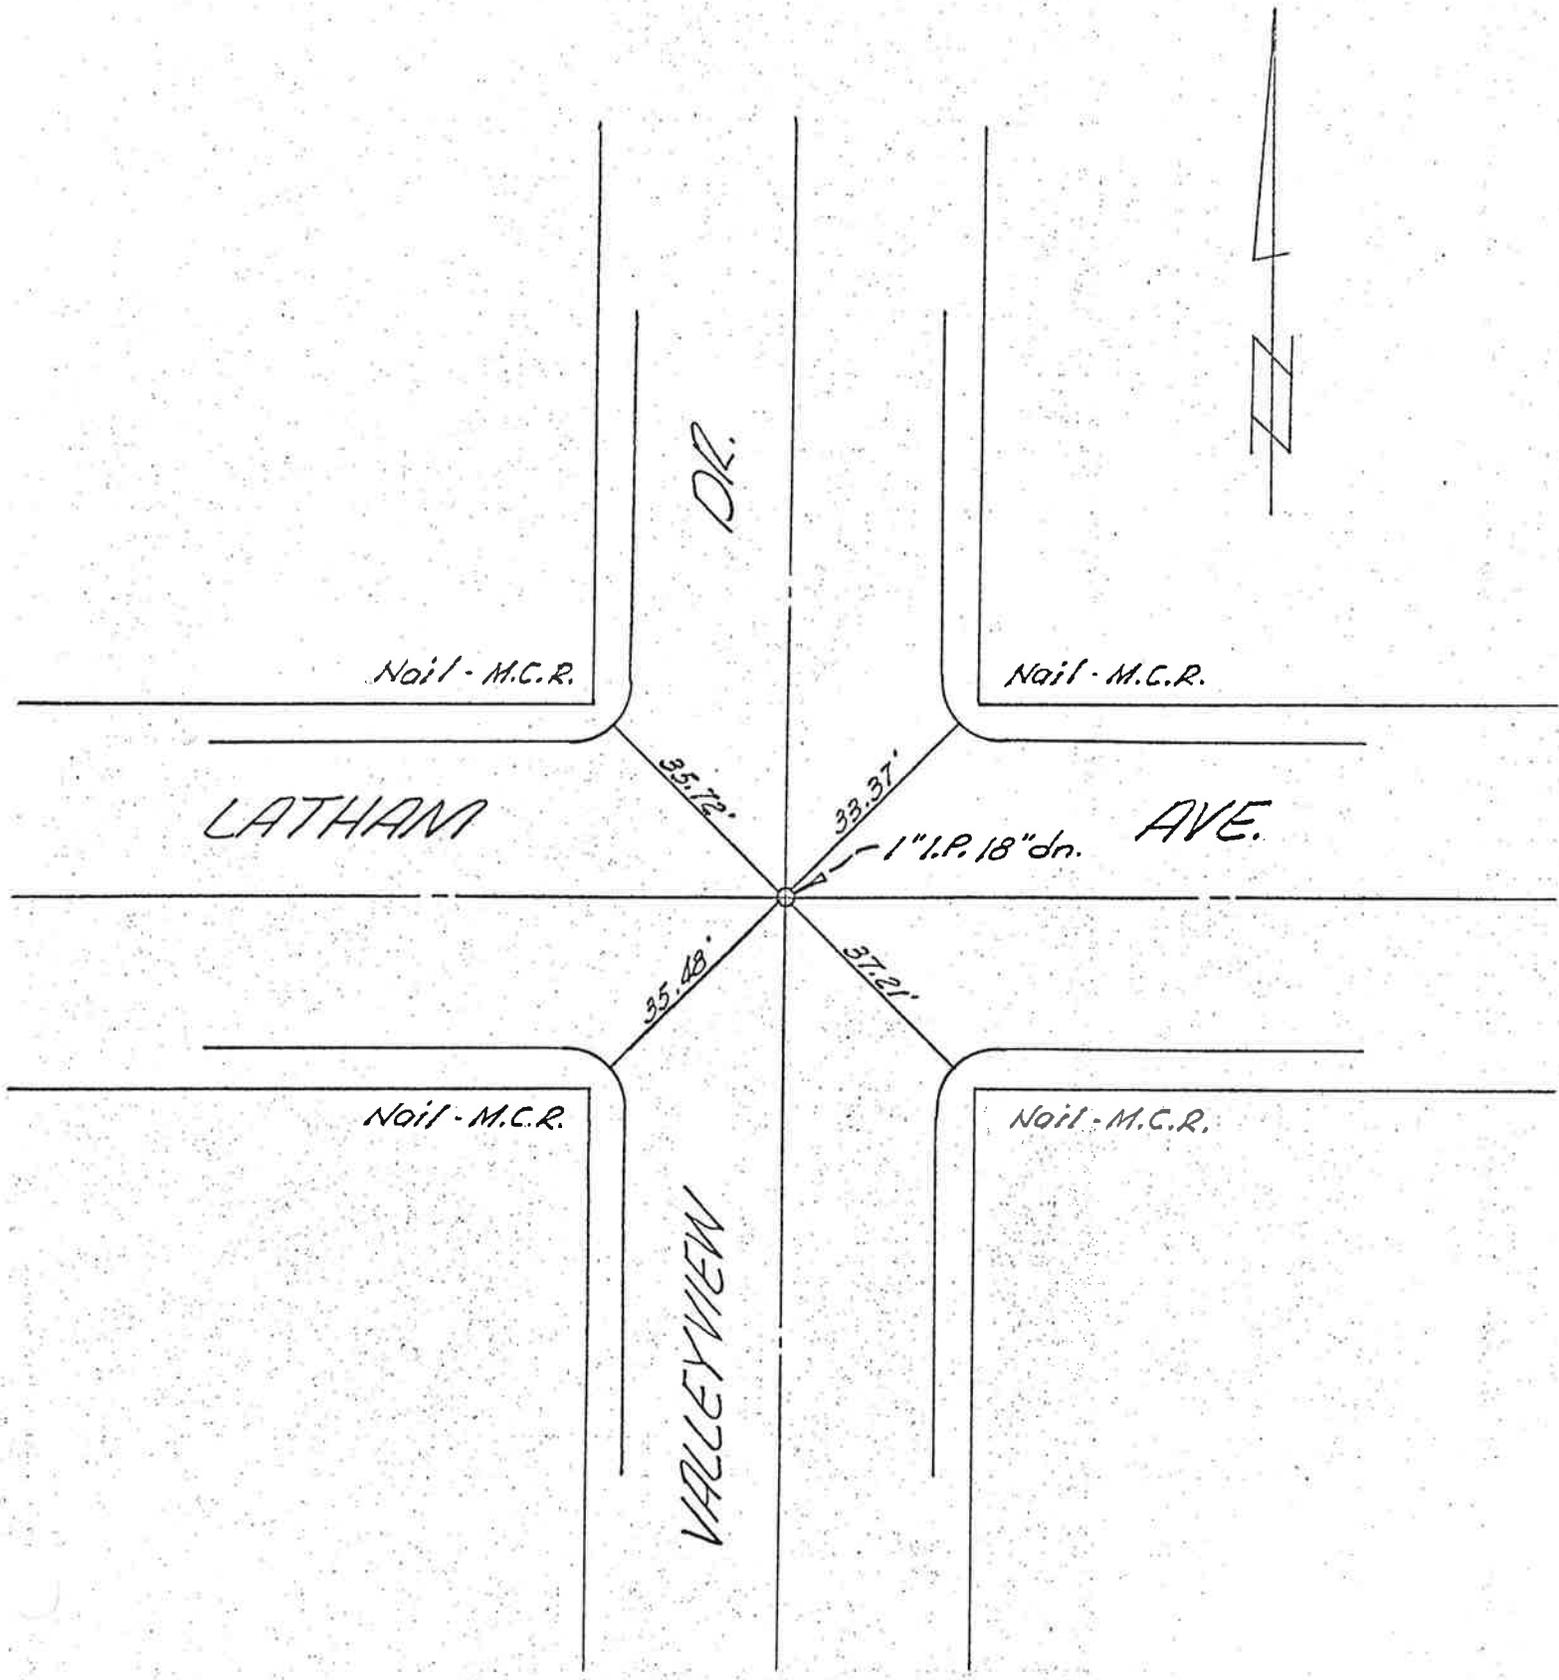

9

full


DATE 12-27-70

JOB NO _____

TIES - ACACIA AVE & KIRBY ST


BY M.L. CHK'D _____

SHEET _____ OF _____

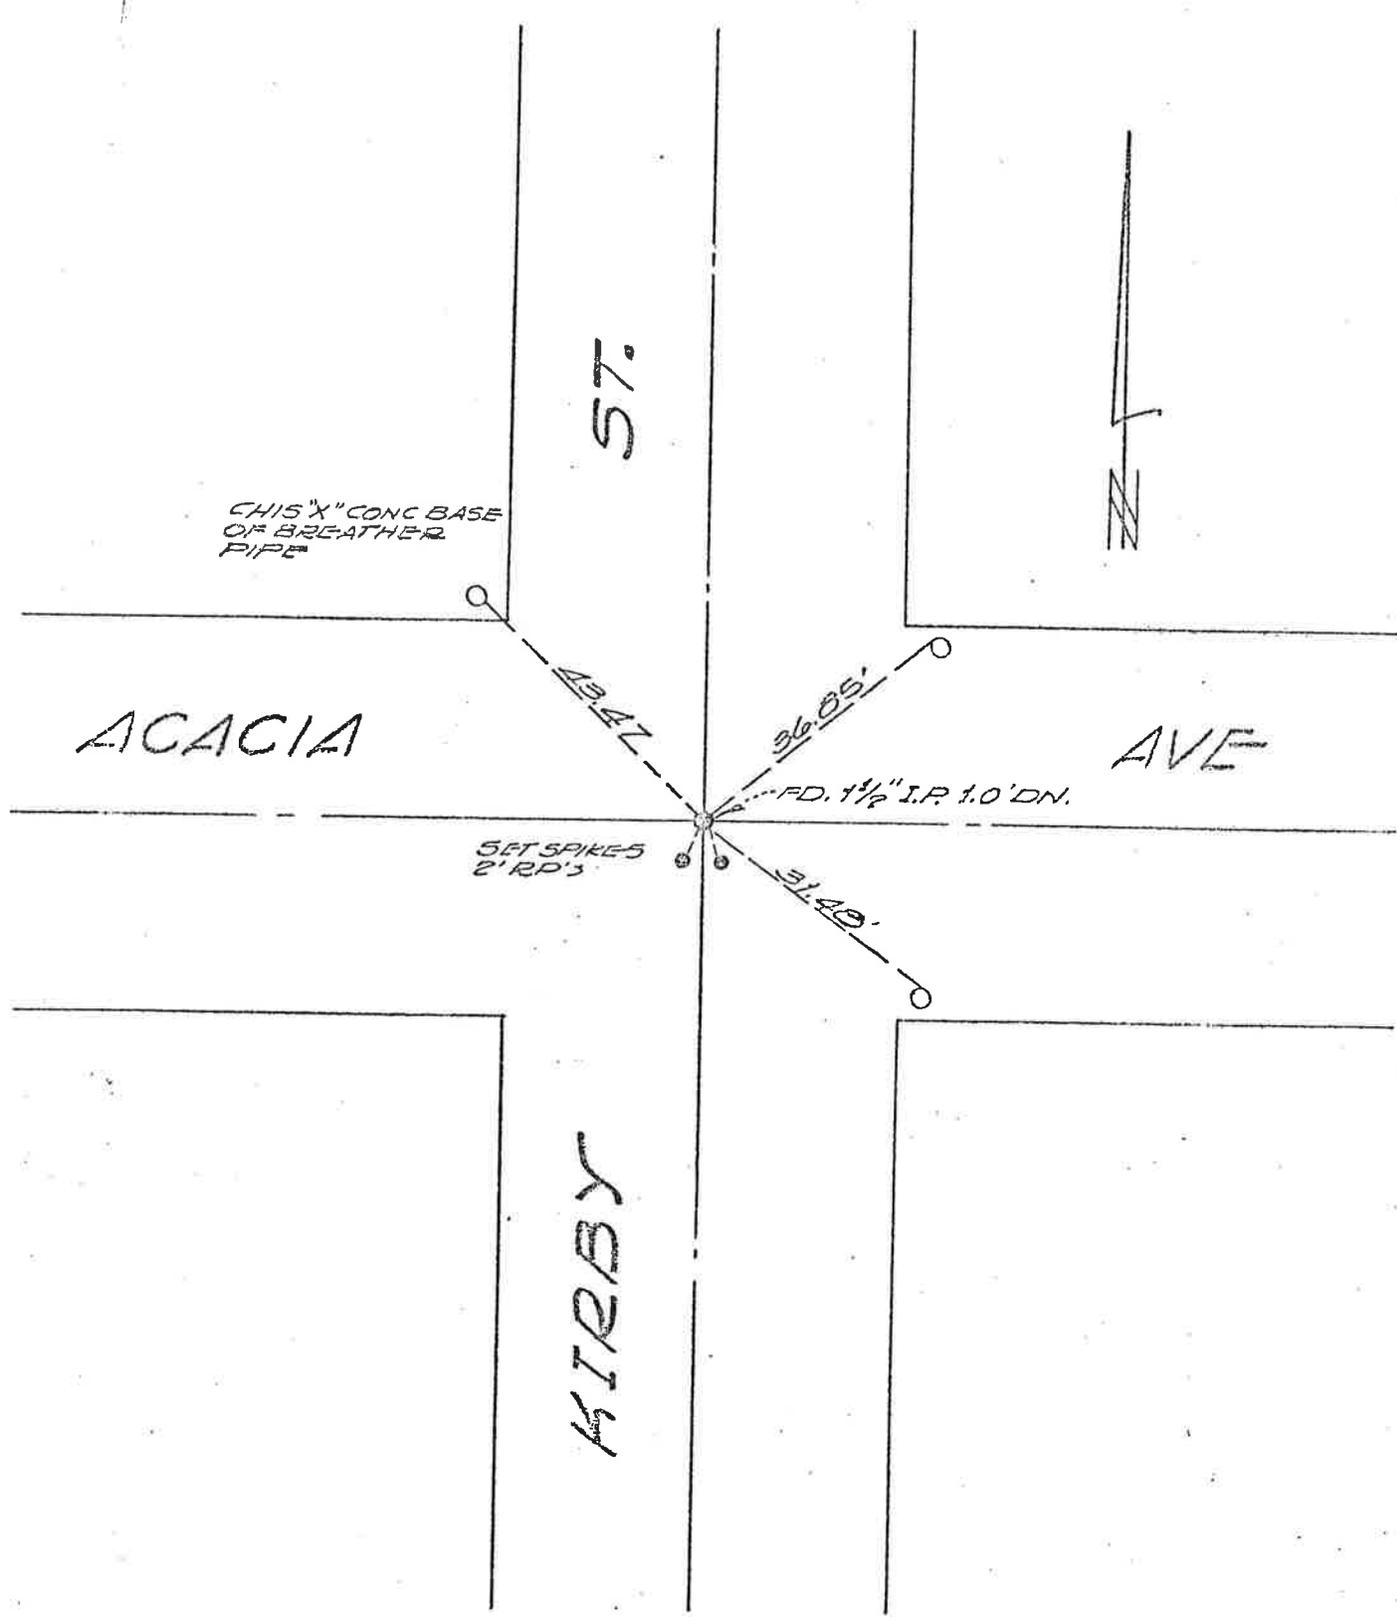

MONUMENT TIES

SECTION 9 TOWNSHIP 5S RANGE 1W

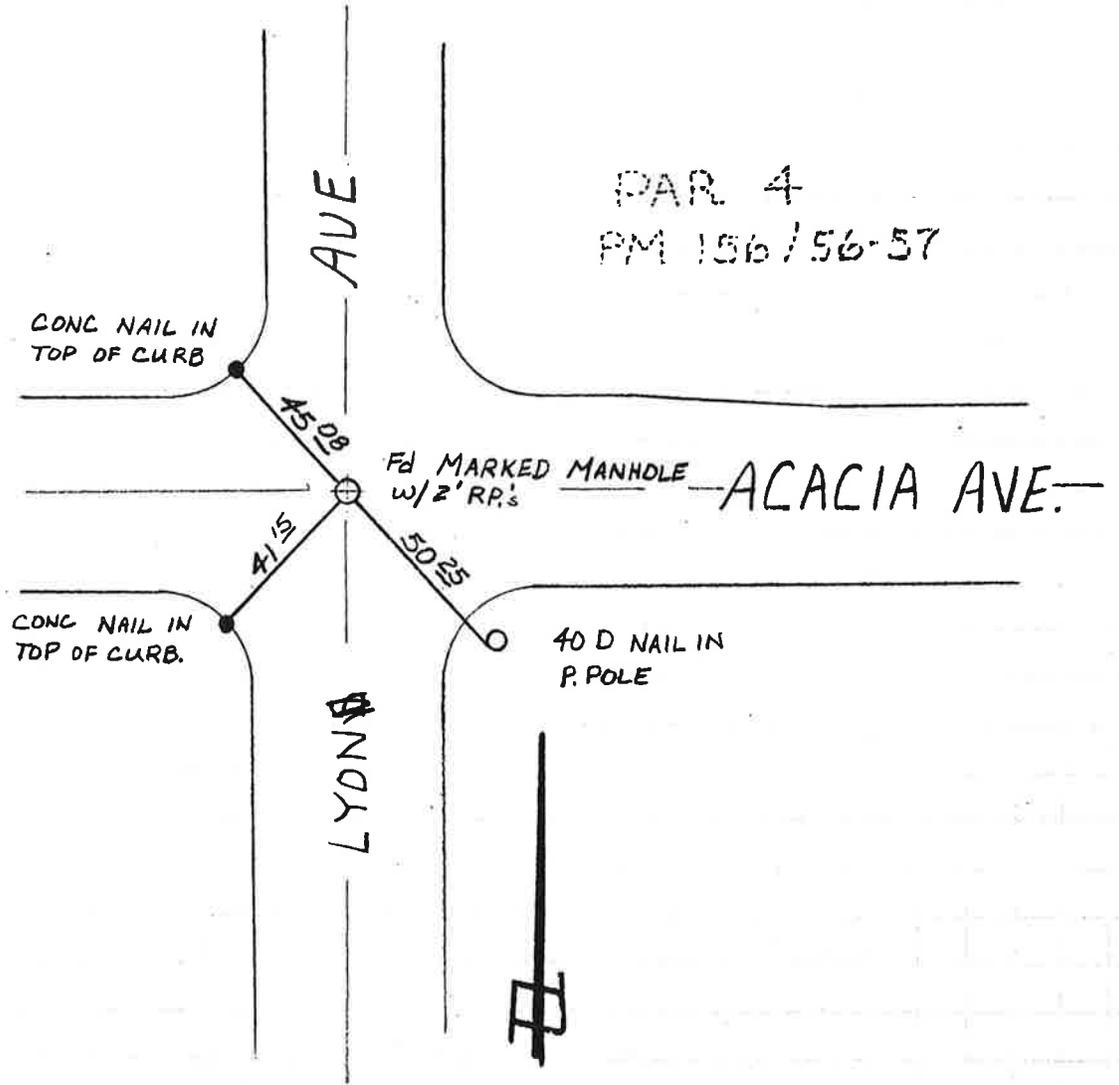


⊕ INDICATES MARKED MANHOLE PER P.M.
156/56-57 AND RS. 60/3.

MONUMENT TIES

SECTION 9 TOWNSHIP 5S RANGE 1W

TRACT NO. 14871-1

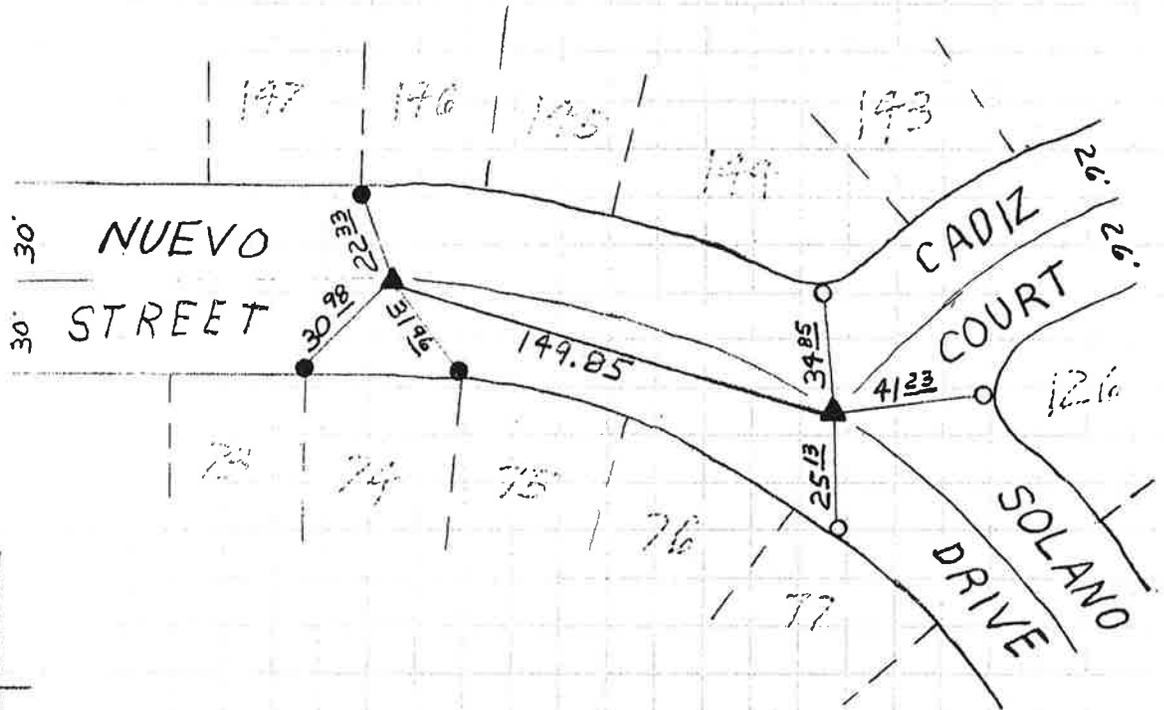

- ▲ SURVEY MONUMENT PER CITY OF HEMET STDS. M-900, M-900A & M-901.
- NAIL & TAG RCE 14232 OR LEAD & TACK IN TOP OF CURB.
- CONCRETE NAIL IN TOP OF CURB.


11/90

City of Hemet
450 E. Latham Ave., Hemet, CA 92343

MONUMENT TIES

SECTION 9 TOWNSHIP 5S RANGE 1W

TRACT NO. 17871-1

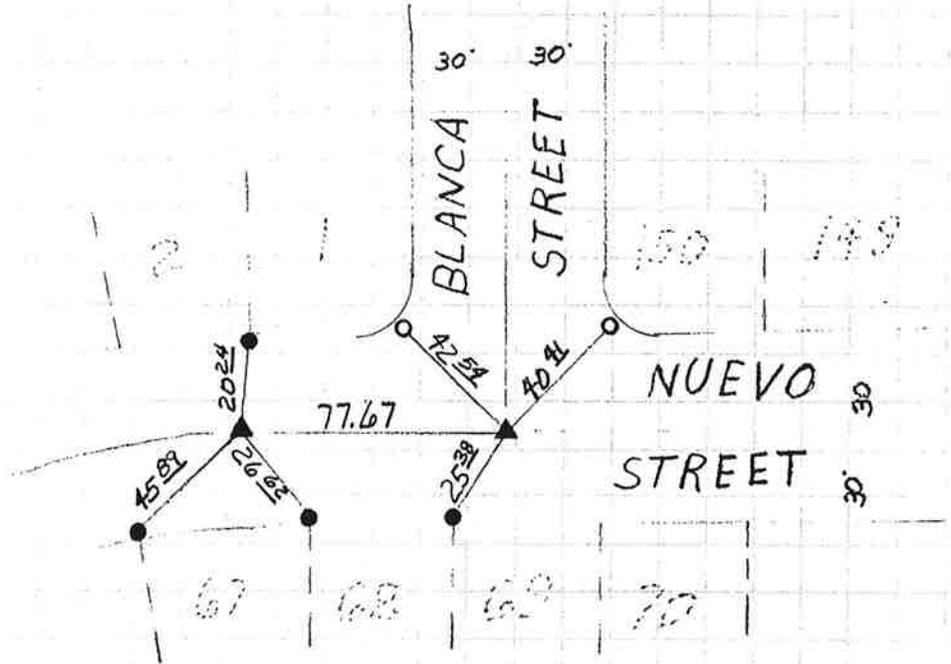


- ▲ SURVEY MONUMENT PER CITY OF HEMET STDS. M-900, M-900A & M-901.
- NAIL & TAG RCE 14232 OR LEAD & TACK IN TOP OF CURB.
- CONCRETE NAIL IN TOP OF CURB.

11/90

MONUMENT TIES

SECTION 9 TOWNSHIP 5 S RANGE 1 W

TRACT NO. 14871-1

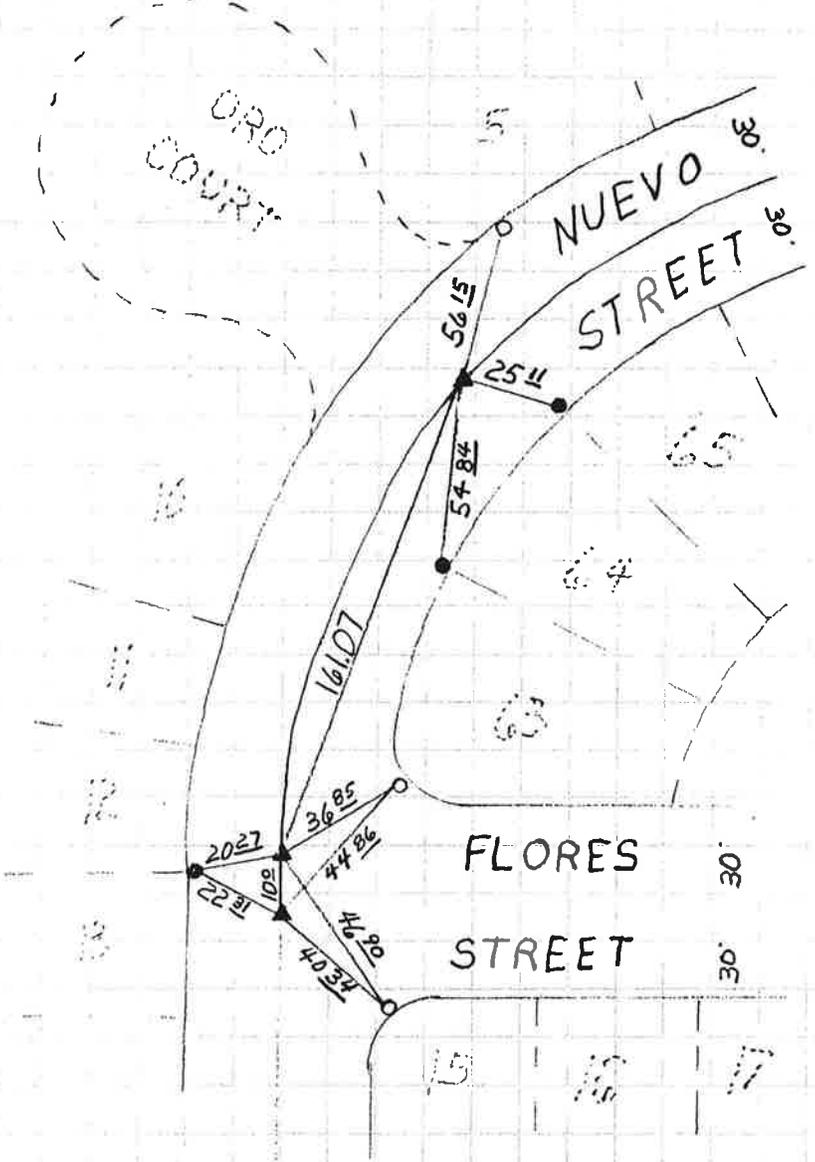

- ▲ SURVEY MONUMENT PER CITY OF HEMET STDS. M-900, M-900A & M-901.
- NAIL & TAG RCE 14232 OR LEAD & TACK IN TOP OF CURB.
- CONCRETE NAIL IN TOP OF CURB.


11/90

City of Hemet
 450 E. Latham Ave., Hemet, CA 92343

MONUMENT TIES

SECTION 9 TOWNSHIP 5S RANGE 1W

TRACT NO. 14871-1

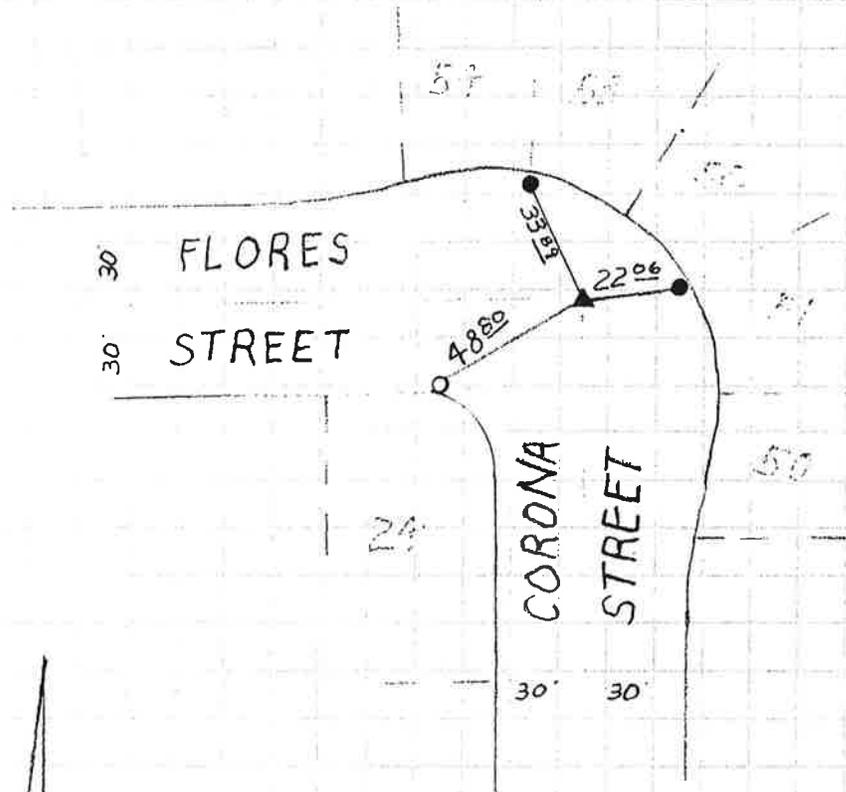

City of Hemet

450 E. Latham Ave., Hemet, CA 92343


- ▲ SURVEY MONUMENT PER CITY OF HEMET STDS. M-900, M-900A & M-901.
- NAIL & TAG RCE 14232 OR LEAD & TACK IN TOP OF CURB.
- CONCRETE NAIL IN TOP OF CURB.

11/90

MONUMENT TIES

SECTION 9 TOWNSHIP 55 RANGE 1W

TRACT NO. 7355

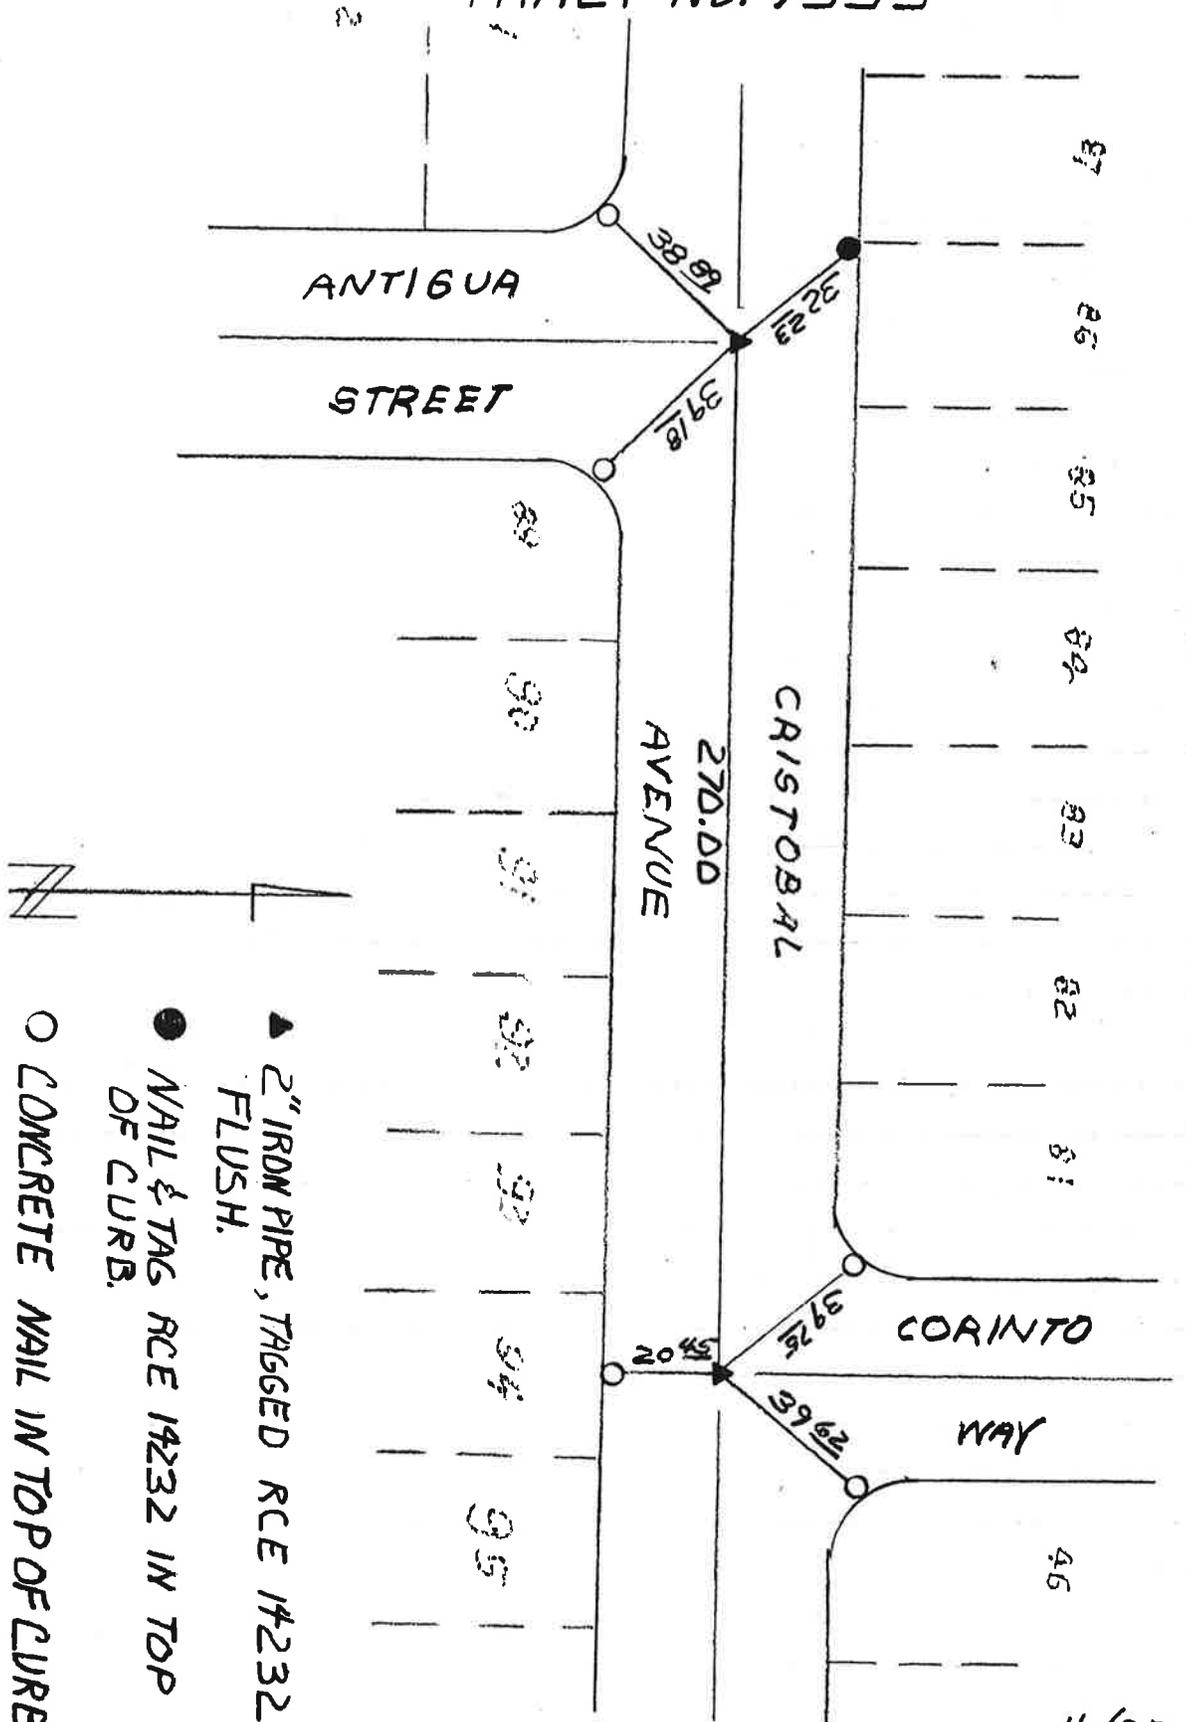


- ▲ 2" IRON PIPE, TAGGED RCE 14232 FLUSH.
- NAIL & TAG RCE 14232 IN TOP OF CURB.
- CONCRETE NAIL IN TOP OF CURB.

06/11

MONUMENT TIES

SECTION 9 TOWNSHIP 5 S RANGE 1 W

TRACT NO. 7355

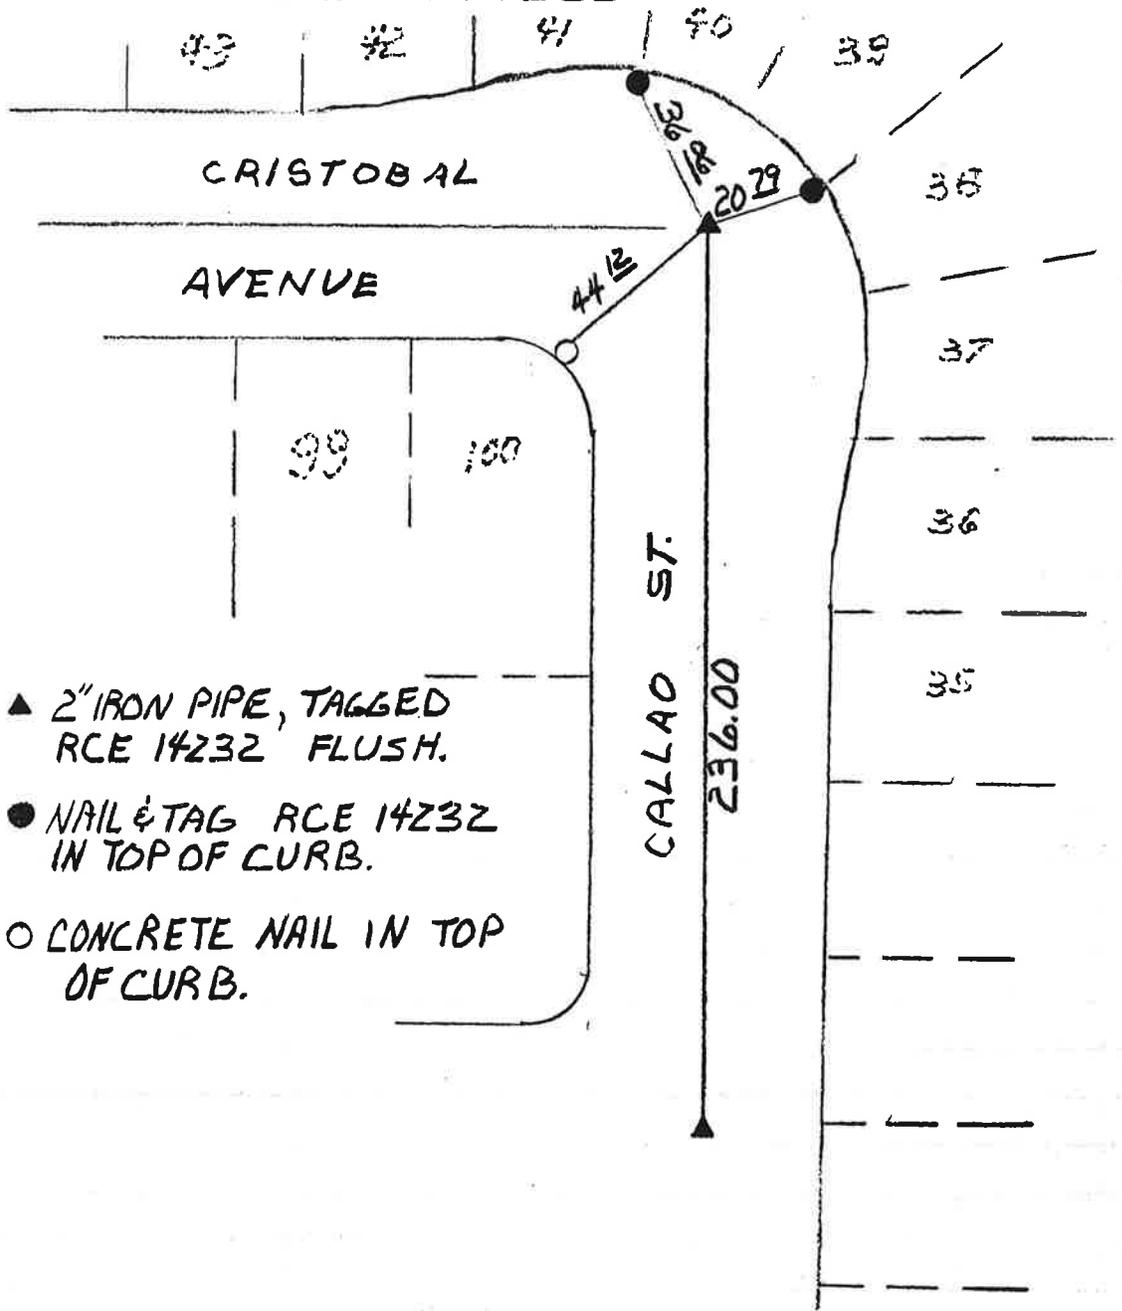


- ▲ 2" IRON PIPE, TAGGED RCE 14232 FLUSH.
- NAIL & TAG RCE 14232 IN TOP OF CURB.
- CONCRETE NAIL IN TOP OF CURB.



MONUMENT TIES

SECTION 9 TOWNSHIP 5S RANGE 1W

TRACT NO. 7355

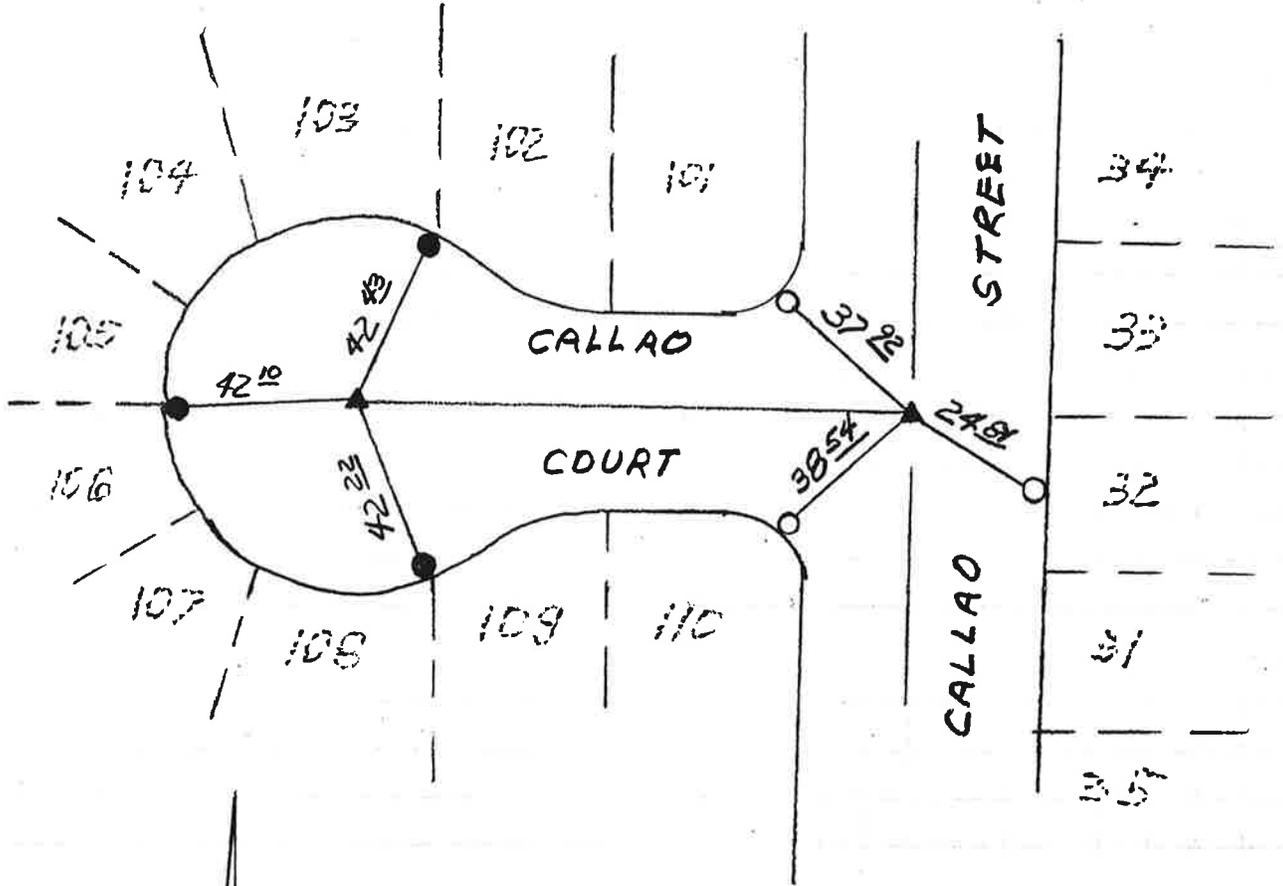

- ▲ 2" IRON PIPE, TAGGED RCE 14232 FLUSH
- NAIL & TAG, RCE 14232 IN TOP OF CURB
- CONCRETE NAIL IN TOP OF CURB.


City of Hemet
450 E. Latham Ave., Hemet, CA 92343

10/90

MONUMENT TIES

SECTION 9 TOWNSHIP 5S RANGE 1W


TRACT NO. 7355

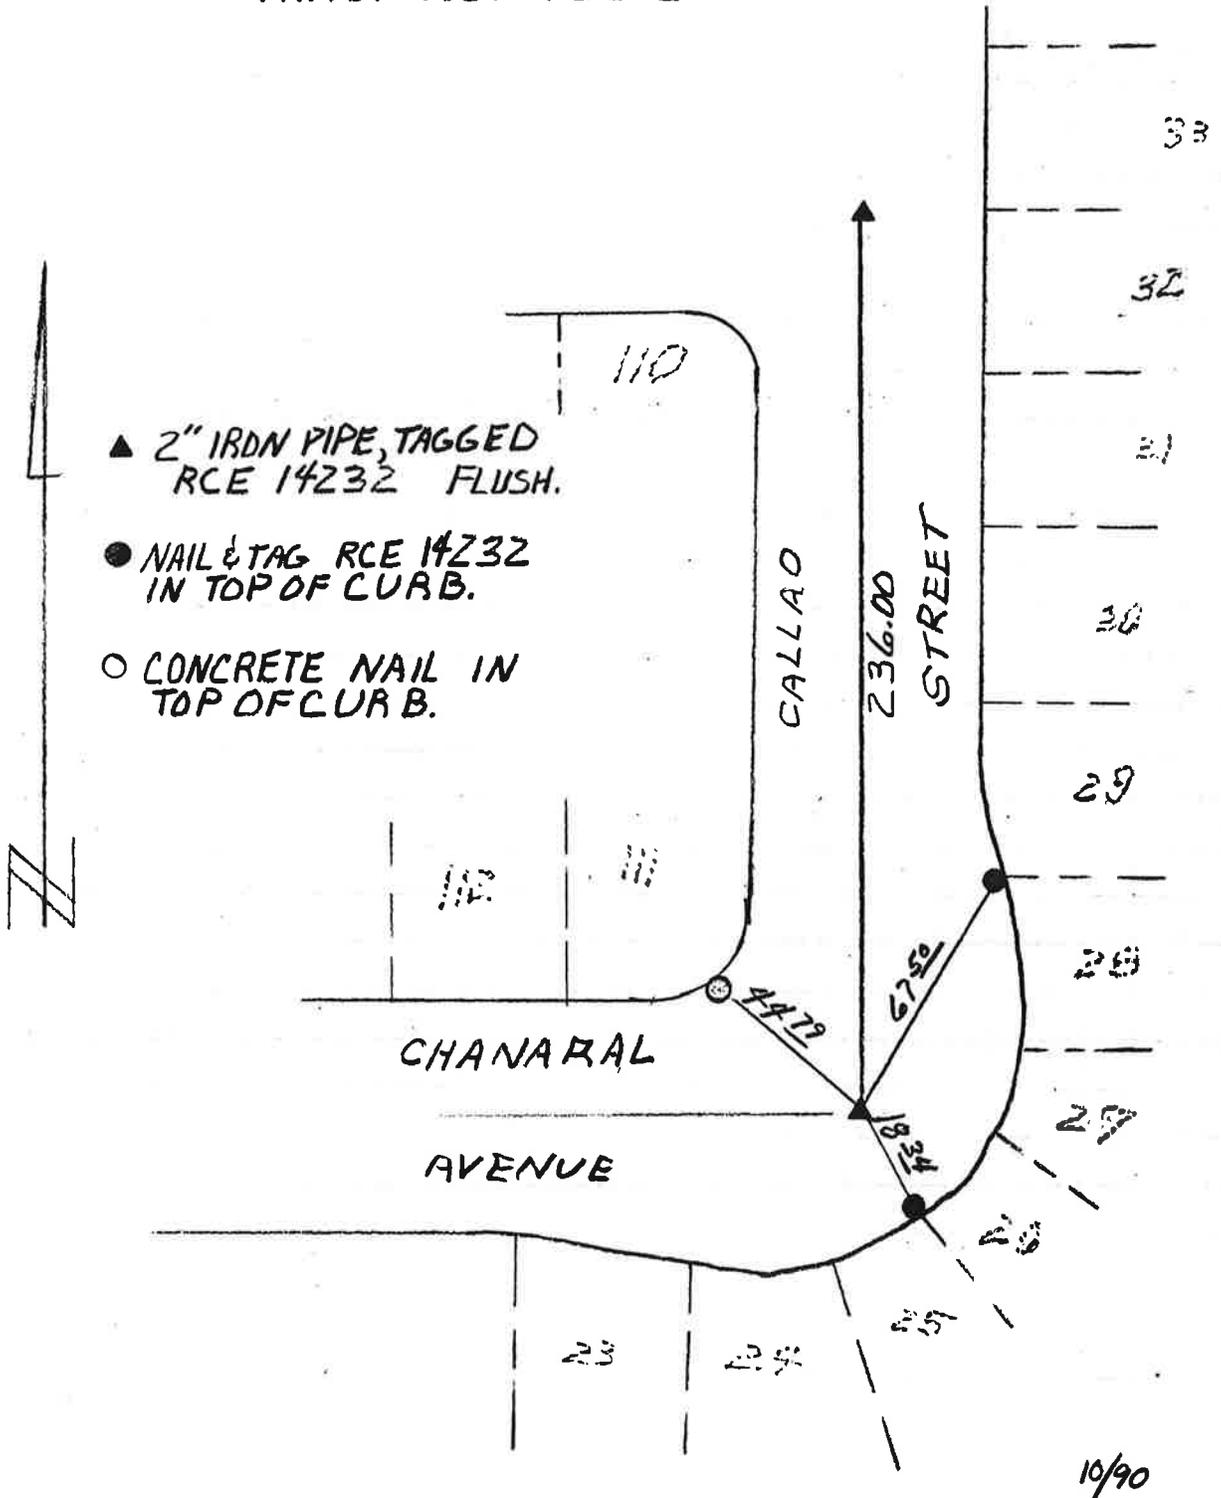

MONUMENT TIES

SECTION 9 TOWNSHIP 5S RANGE 1W

TRACT NO. 7355

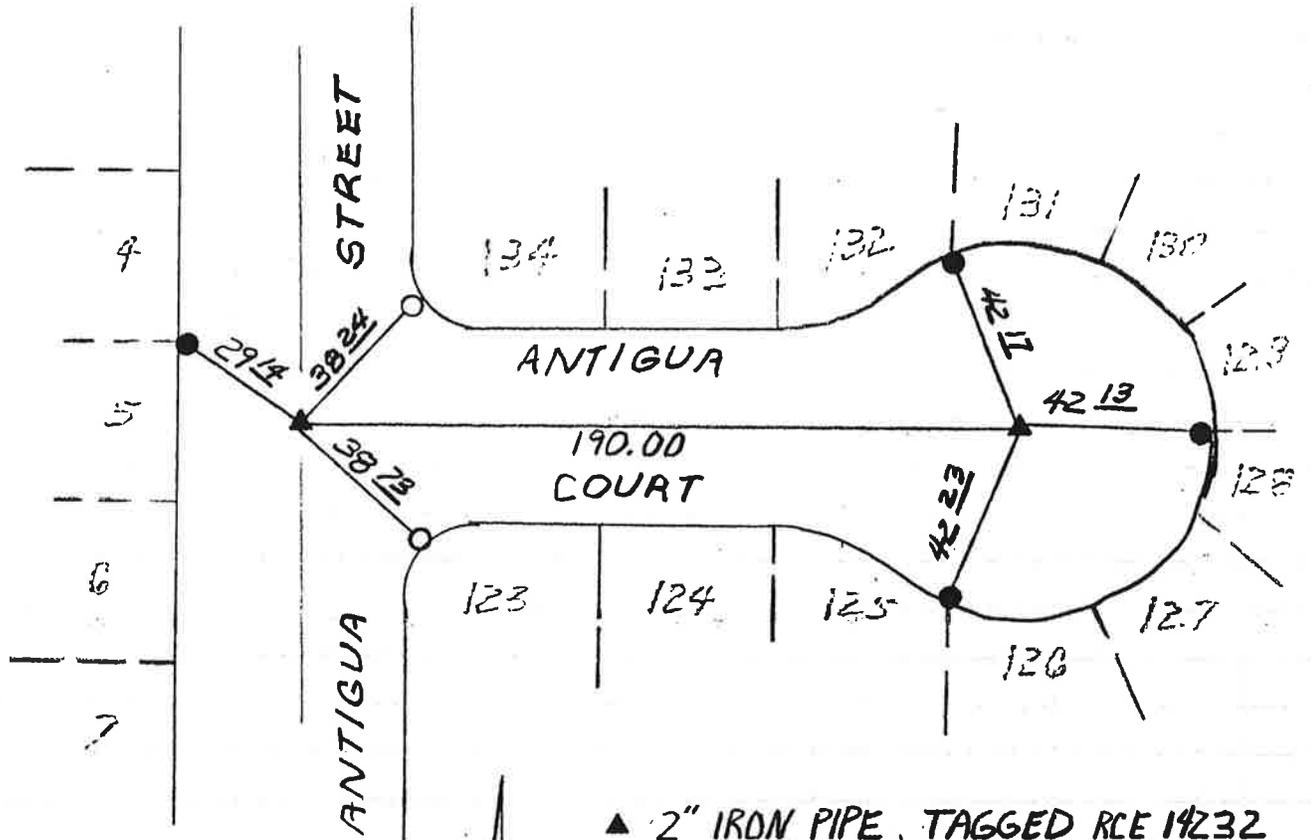


- ▲ 2" IRON PIPE, TAGGED RCE 14232 FLUSH.
- NAIL TAG RCE 14232 IN TOP OF CURB.
- ◻ CONCRETE NAIL IN TOP OF CURB.

10/90

City of Hemet
450 E. Latham Ave., Hemet, CA 92343

MONUMENT TIES

SECTION 9 TOWNSHIP 5 S RANGE 1 W

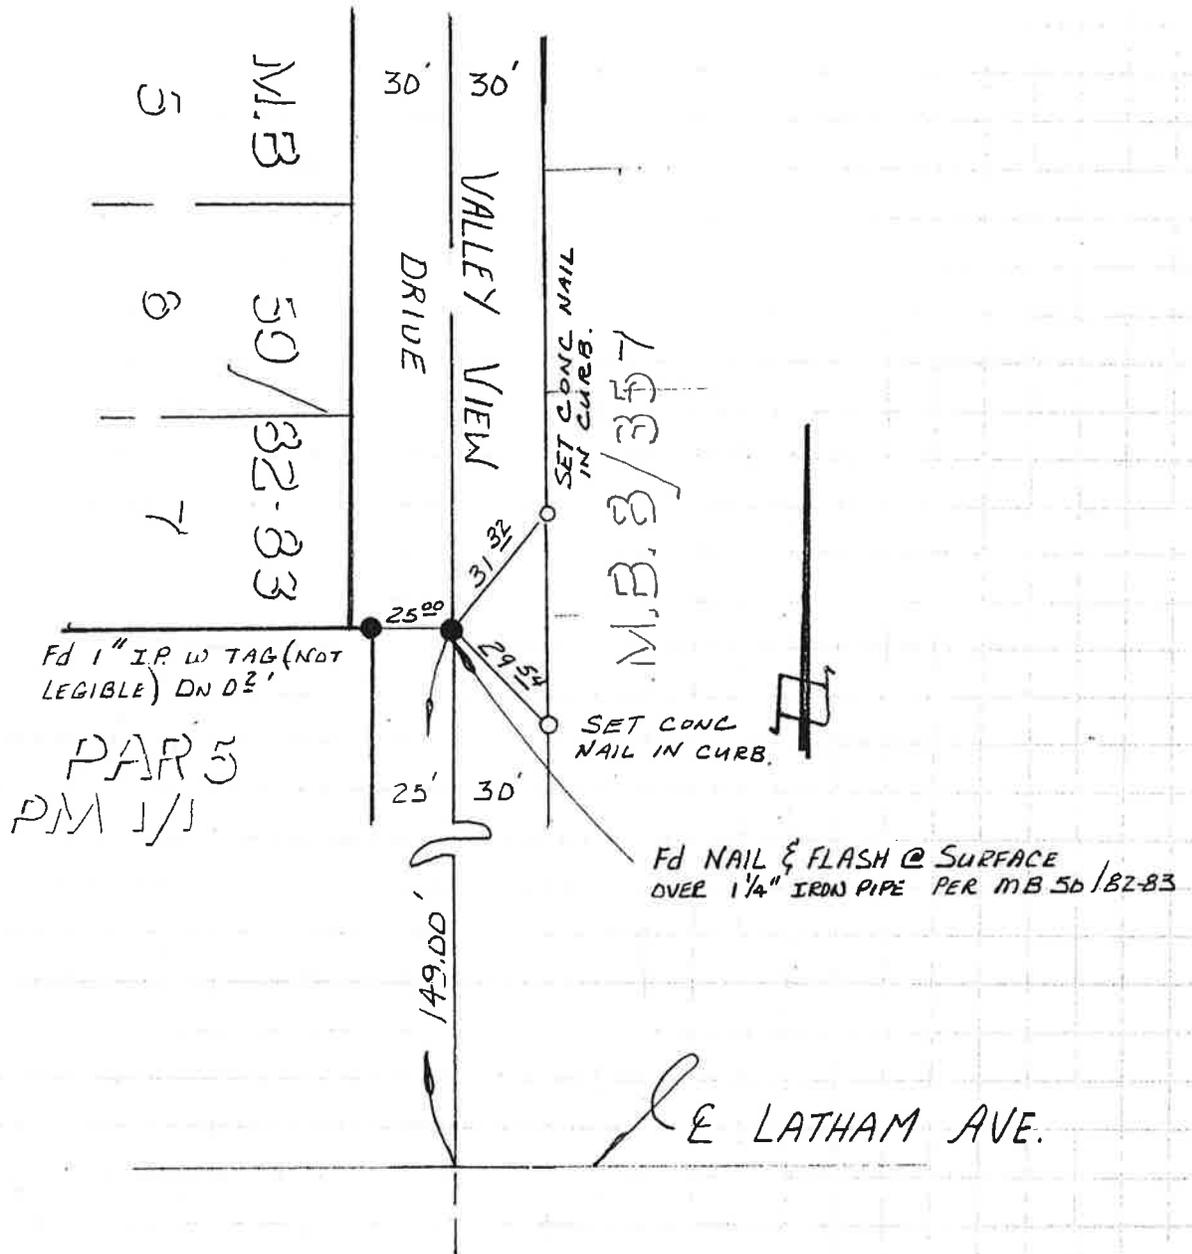


- INDICATES MONUMENTS FOUND, SIZE AND DESCRIPTION AS NOTED.
- INDICATES CONCRETE NAILS SET IN CURB FOR R.P. TIES.

11/90

MONUMENT TIES

SECTION 9 TOWNSHIP 5 S RANGE 1 W

- INDICATES MONUMENTS FOUND SIZE AND DESCRIPTION AS NOTED.
- INDICATES 1/4" I.P. SET FLUSH AND TAGGED LS#6054

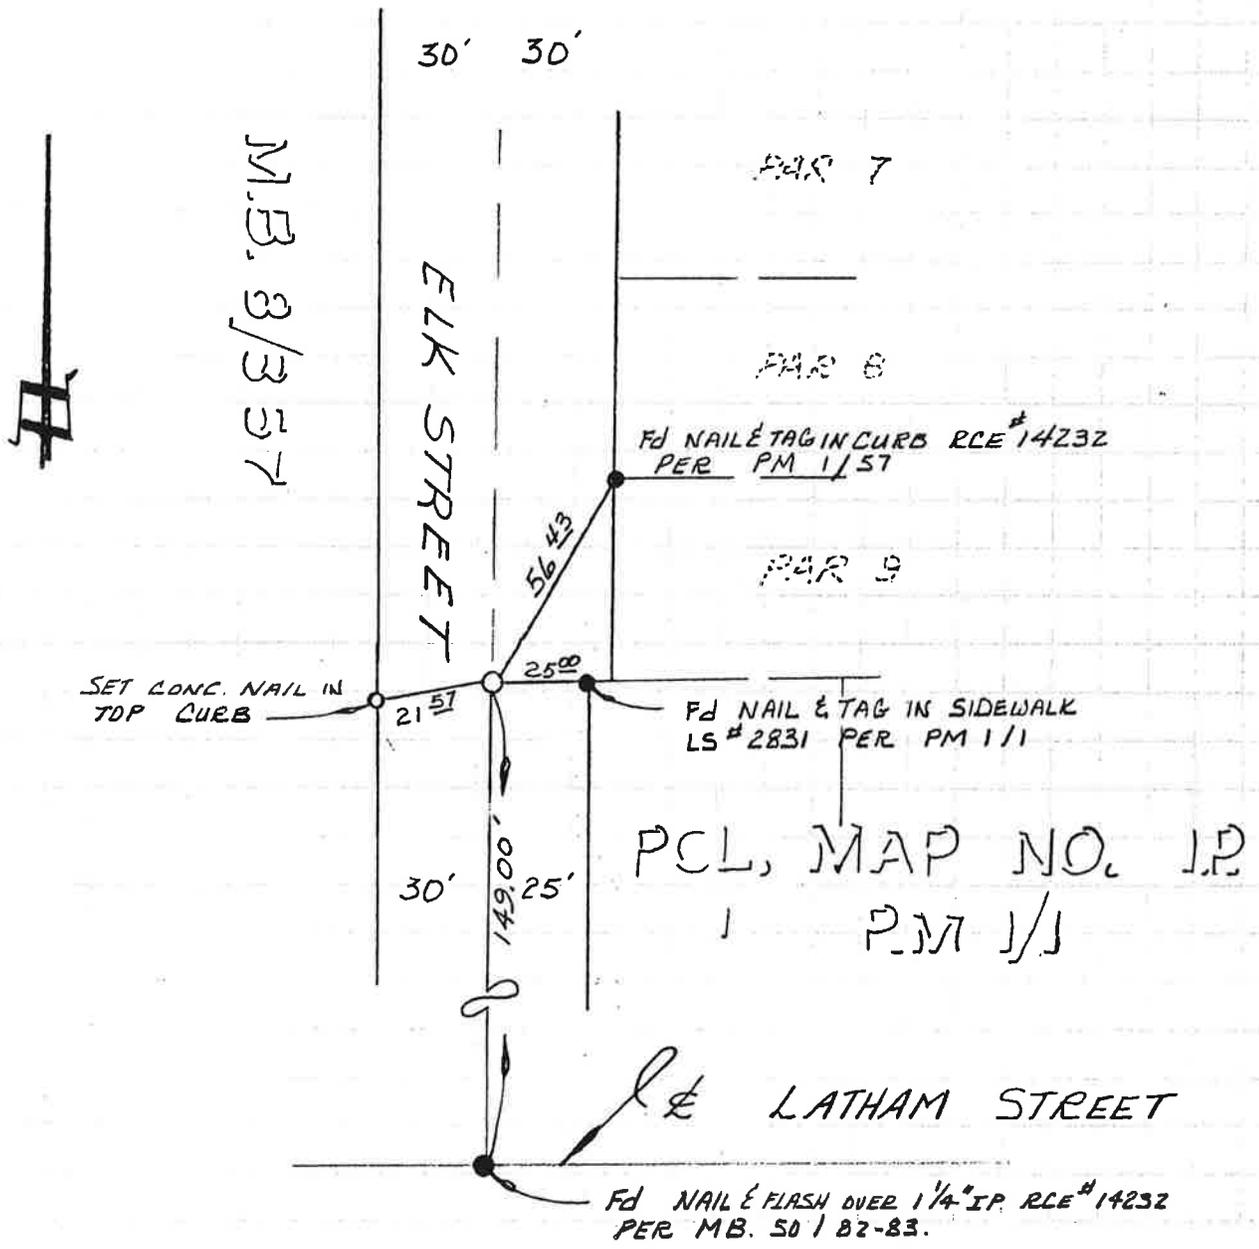


11/90

City of Hemet
450 E. Latham Ave., Hemet, CA 92343

MONUMENT TIES

SECTION 9 TWP 5S RANGE 1W

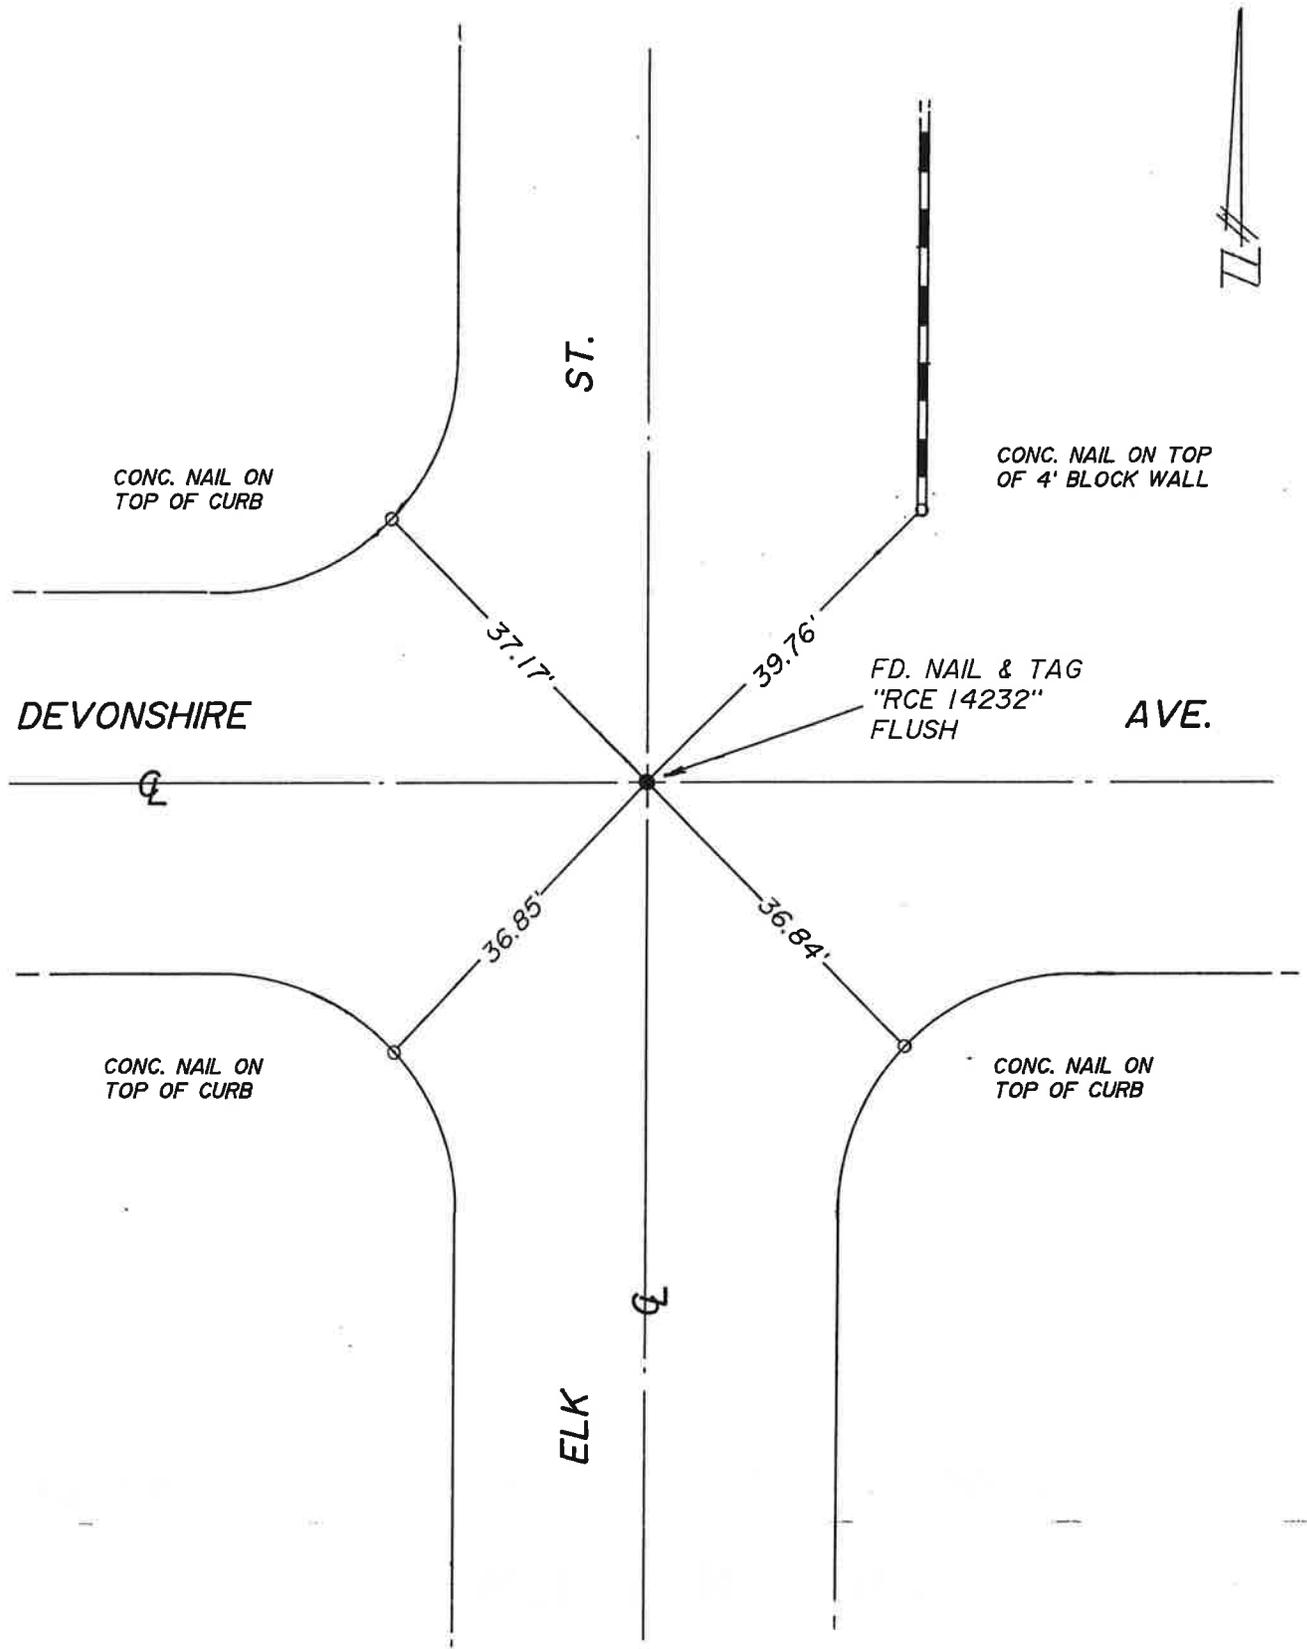

City of Hemet



480 EAST LATHAM AVENUE • HEMET, CALIFORNIA 92343 • (714) 858-9411

253 819 79

CP Notes
Rich
Kench

Line

STATE OF CALIFORNIA

DIVISION OF HIGHWAYS

ALIGNMENT

Riv 7A ^{pm 37.51} ^{N.V. Lofy} ¹⁰⁸⁷ Date 4-10-69 9

Pl.

Overcast, cool

Q Imp
750+07.89 PI
S.H.
see page 10.

M-660.41
660.09
C-660.12

N.V.F. of
E. Florida

Q Imp
750+27.76 PI
S.H.

1-179°59'50"
6-859°59'50"
N-179°59'56.3"

1-181°55'00"
6-85°00'00"
N-179°00'00.5"

M-1320.870
1320.780
C-1320.84

Kirby Q Imp
Q Imp
790+27.52 PI
N.V.F.
see page 8
sh 67

1-90°03'30"
6-180°23'45"
N-90°03'46.7"

Sec. Cor. 87
Hewlett 1716
Kirby PI.
21.3" H.F.T.

M/2 180°00'50"

8" VC
3 1/4" H.F.T.


1-185°00'00"
6-359°59'50"
N-179°59'58.5"

Set by N.V.F. Straddles
over Rod N.V.F. 10-8-59
JKL
1-89°56'10"
6-179°38'00"
N-59°56'20"

fd std brass disc in well
intersected straddles & punched
10/24/69 JI stamped; Q Imp
Q Imp Kirby PI
711+11.35 PI
boat mail.
see page 5


252001

252001-4
Backside

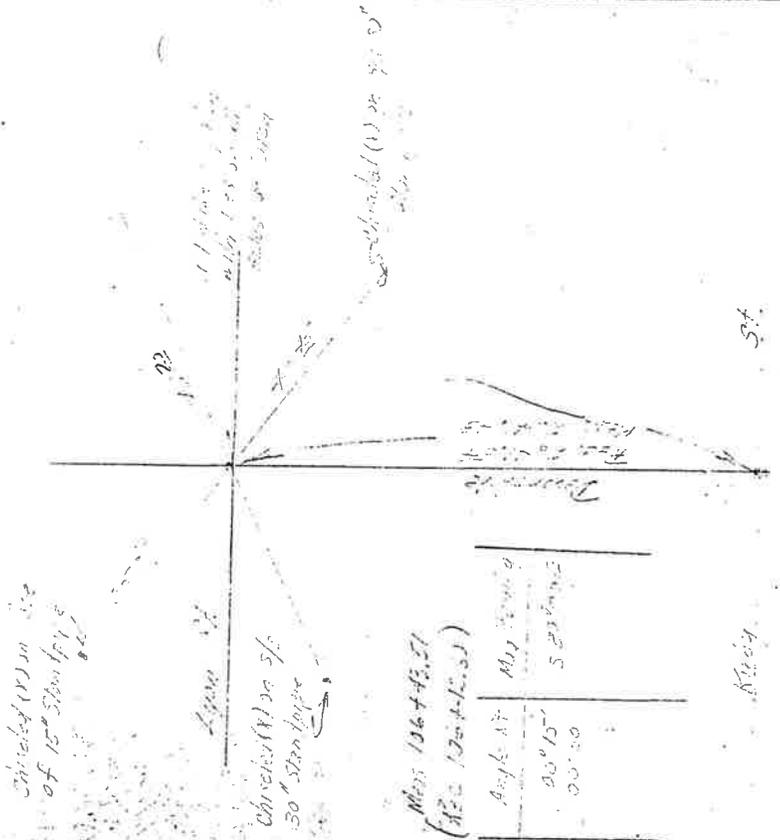

MONUMENT TIES

SECTION 9 TWP 5S RANGE 1W

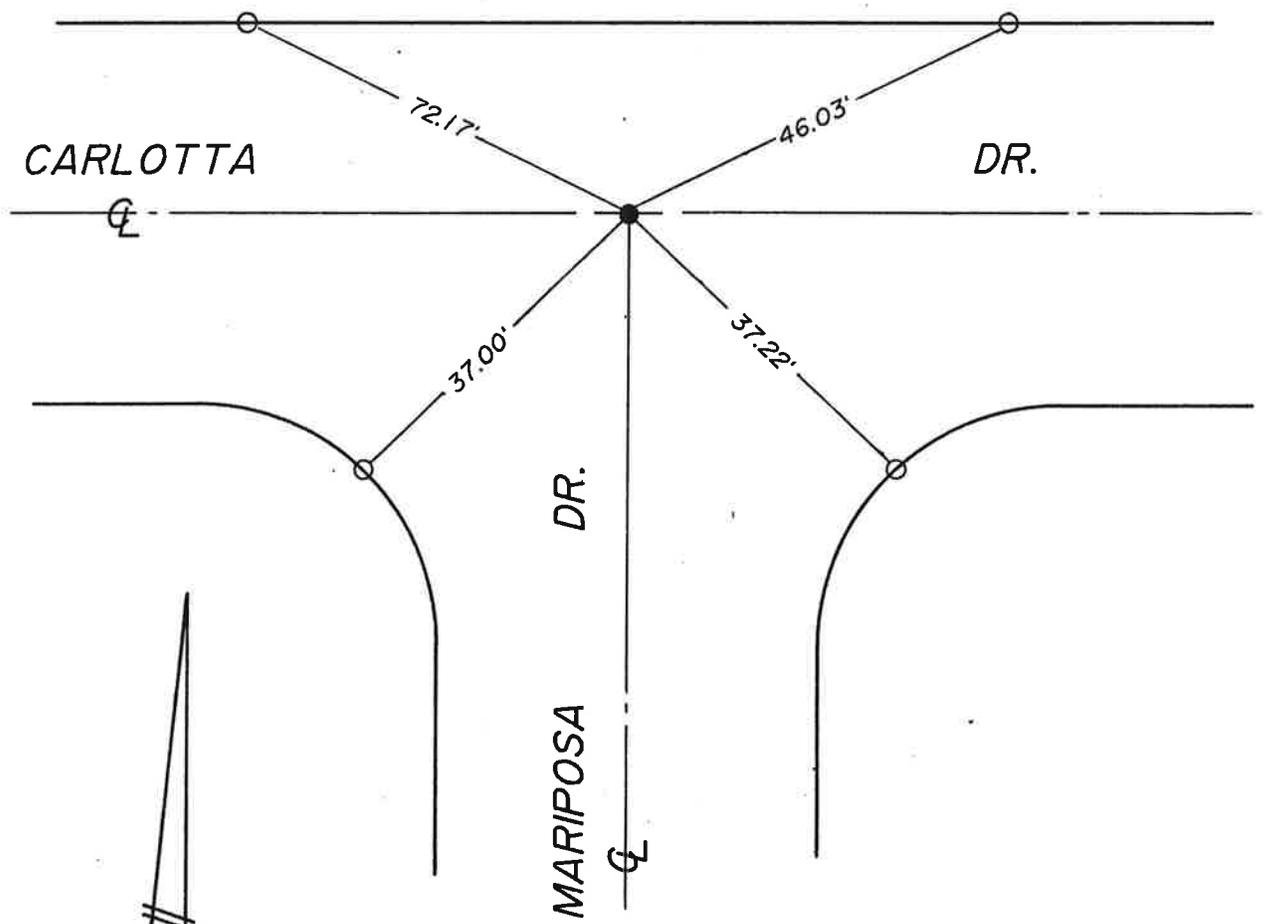

* ● INDICATES FD. 2" BRASS DISC, IN CONC., UNMARKED, DN. 6" IN HAND-WELL.

○ INDICATES SET CONC. NAIL ON TOP OF CURB.

* RESET NAIL & TAG, "LS 3291" FLUSH IN PAVEMENT.


City of Hemet



480 EAST LATNAM AVENUE • HEMET, CALIFORNIA 92343 • (714) 658-0611

MONUMENT TIES

SECTION 9 TWP 5S RANGE 1W

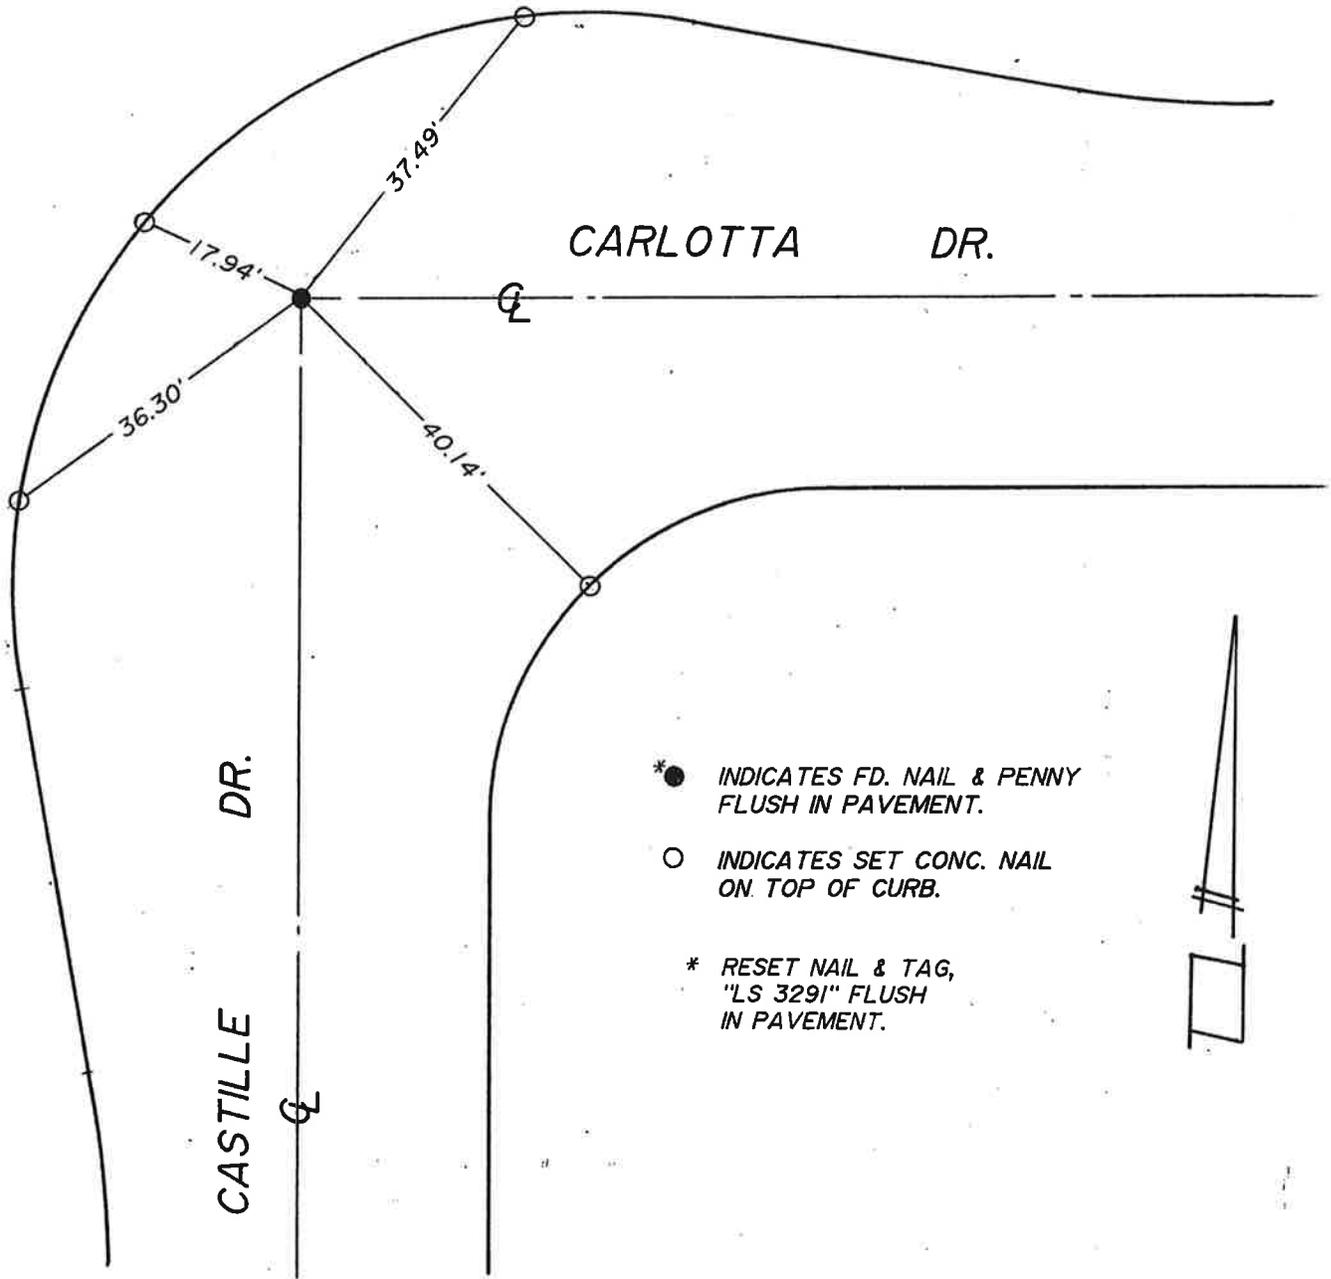

488 EAST LATHAM AVENUE • HEMET, CALIFORNIA 92343 • (714) 658-0411

City of Hemet



CASTILLE DR.

CARLOTTA DR.

* INDICATES FD. NAIL & PENNY
FLUSH IN PAVEMENT.


○ INDICATES SET CONC. NAIL
ON TOP OF CURB.

* RESET NAIL & TAG,
"LS 3291" FLUSH
IN PAVEMENT.



MONUMENT TIES

SECTION 9 TWP 5S RANGE 1W

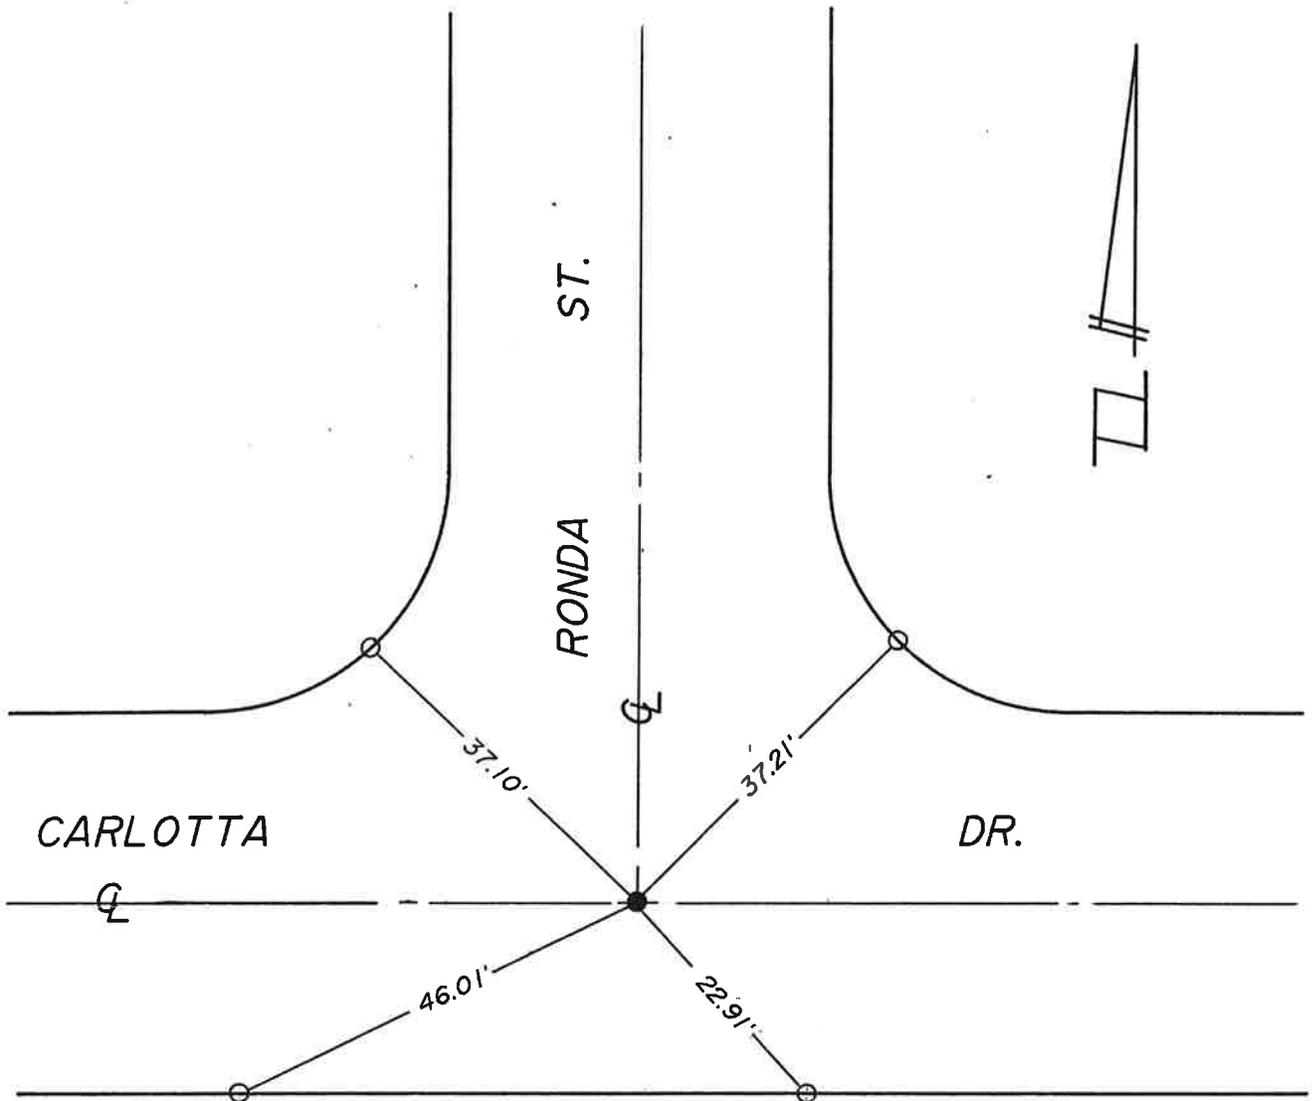

* ● INDICATES FD. 2" BRASS DISC,
UNMARKED, DN. 6" IN HAND-WELL.

○ INDICATES SET CONC. NAIL
ON TOP OF CURB.

* RESET NAIL & TAG,
"LS 3291" FLUSH
IN PAVEMENT.


City of Hemet

488 EAST LATHAM AVENUE • HEMET, CALIFORNIA 92343 • (714) 958-0411



MONUMENT TIES

SECTION 9 TWP 5S RANGE 1W

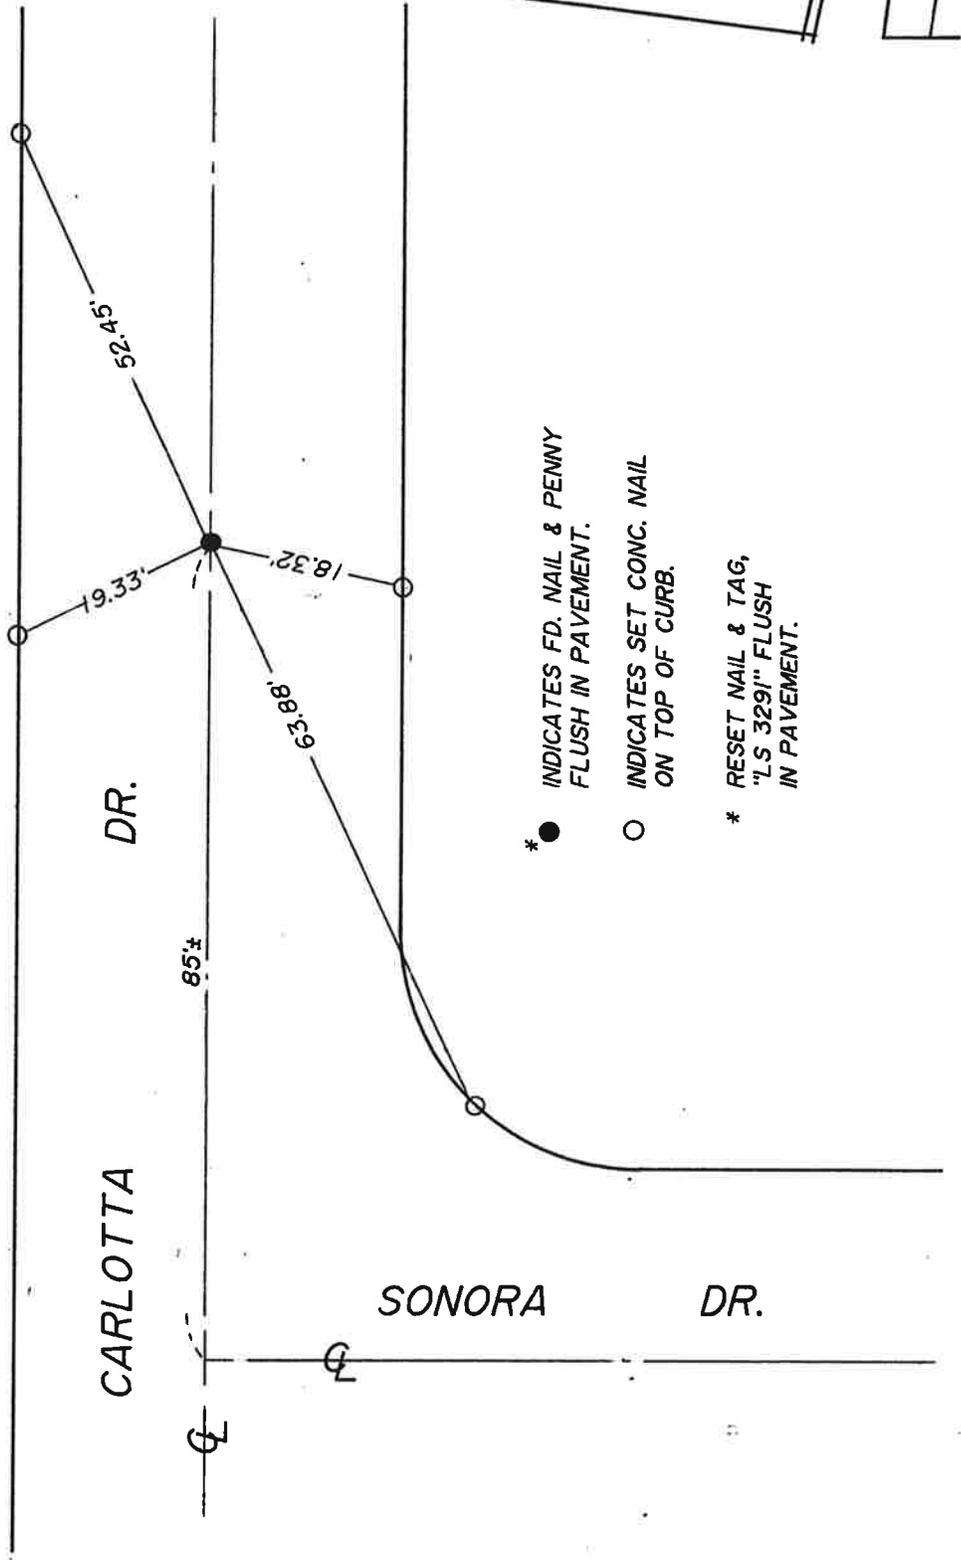

- * ● INDICATES FD. NAIL & PENNY FLUSH IN PAVEMENT.
- INDICATES SET CONC. NAIL ON TOP OF CURB.
- * RESET NAIL & TAG, "LS 329" FLUSH IN PAVEMENT.



City of Hemet

480 EAST LATHAM AVENUE • HEMET, CALIFORNIA 92343 • (714) 658-0411



MONUMENT TIES

SECTION 9 TWP 5S RANGE 1W

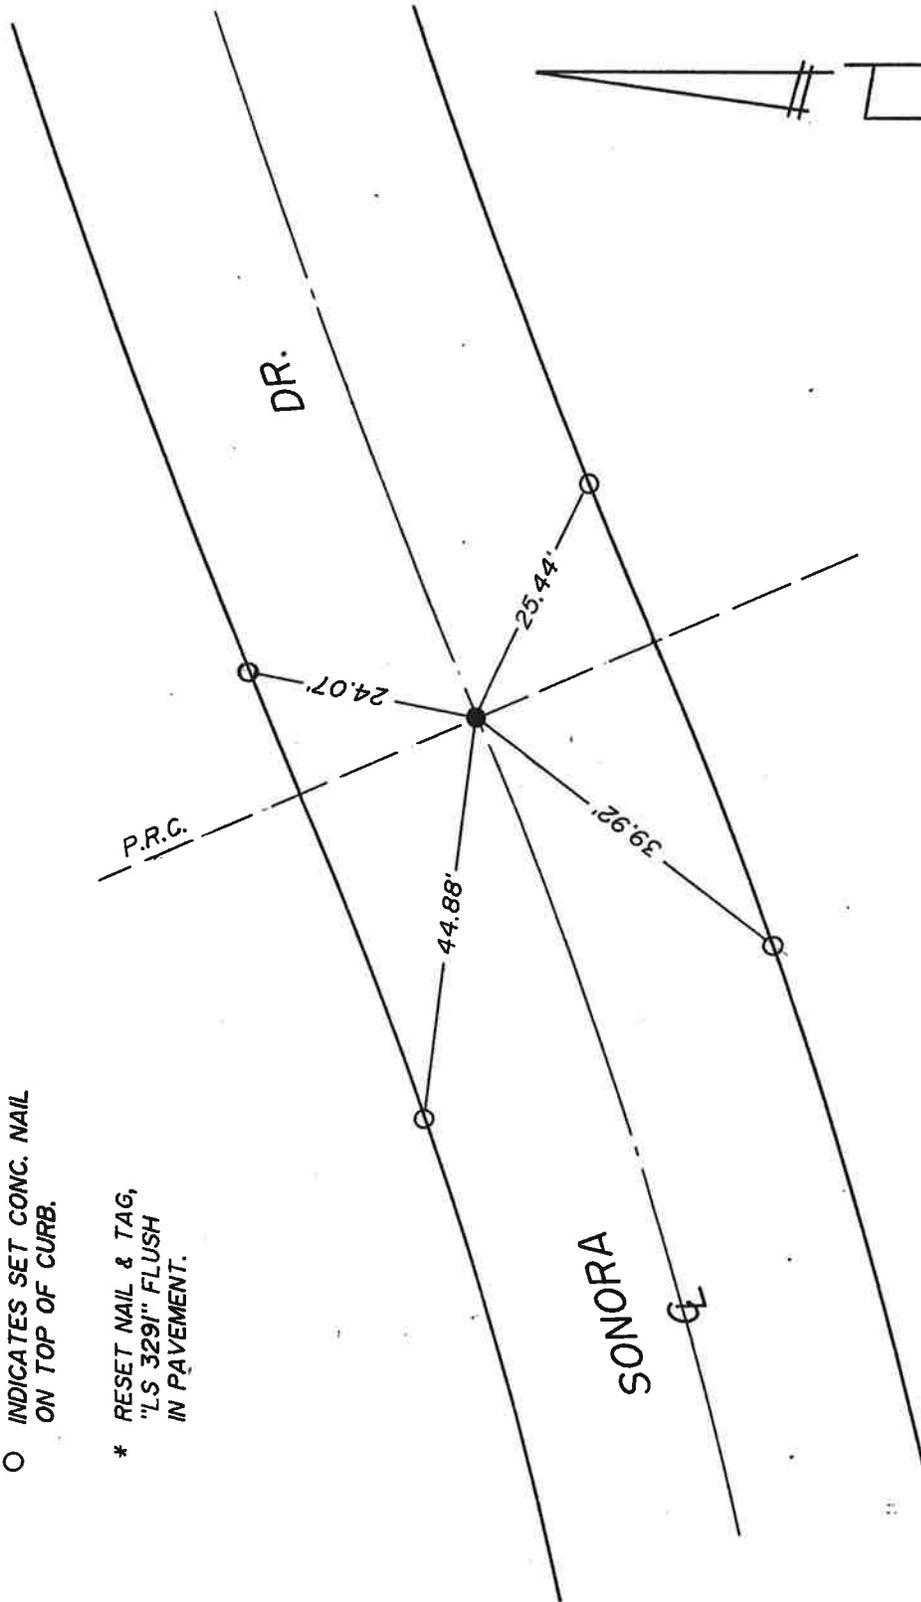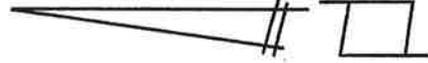

- * ● INDICATES FD. NAIL & PENNY FLUSH IN PAVEMENT.
- INDICATES SET CONC. NAIL ON TOP OF CURB.
- * RESET NAIL & TAG, "LS 3291" FLUSH IN PAVEMENT.


City of Hemet



480 EAST LATHAM AVENUE • HEMET, CALIFORNIA 92343 • (714) 658-8617

MONUMENT TIES

SECTION 9 TWP 5S RANGE 1W

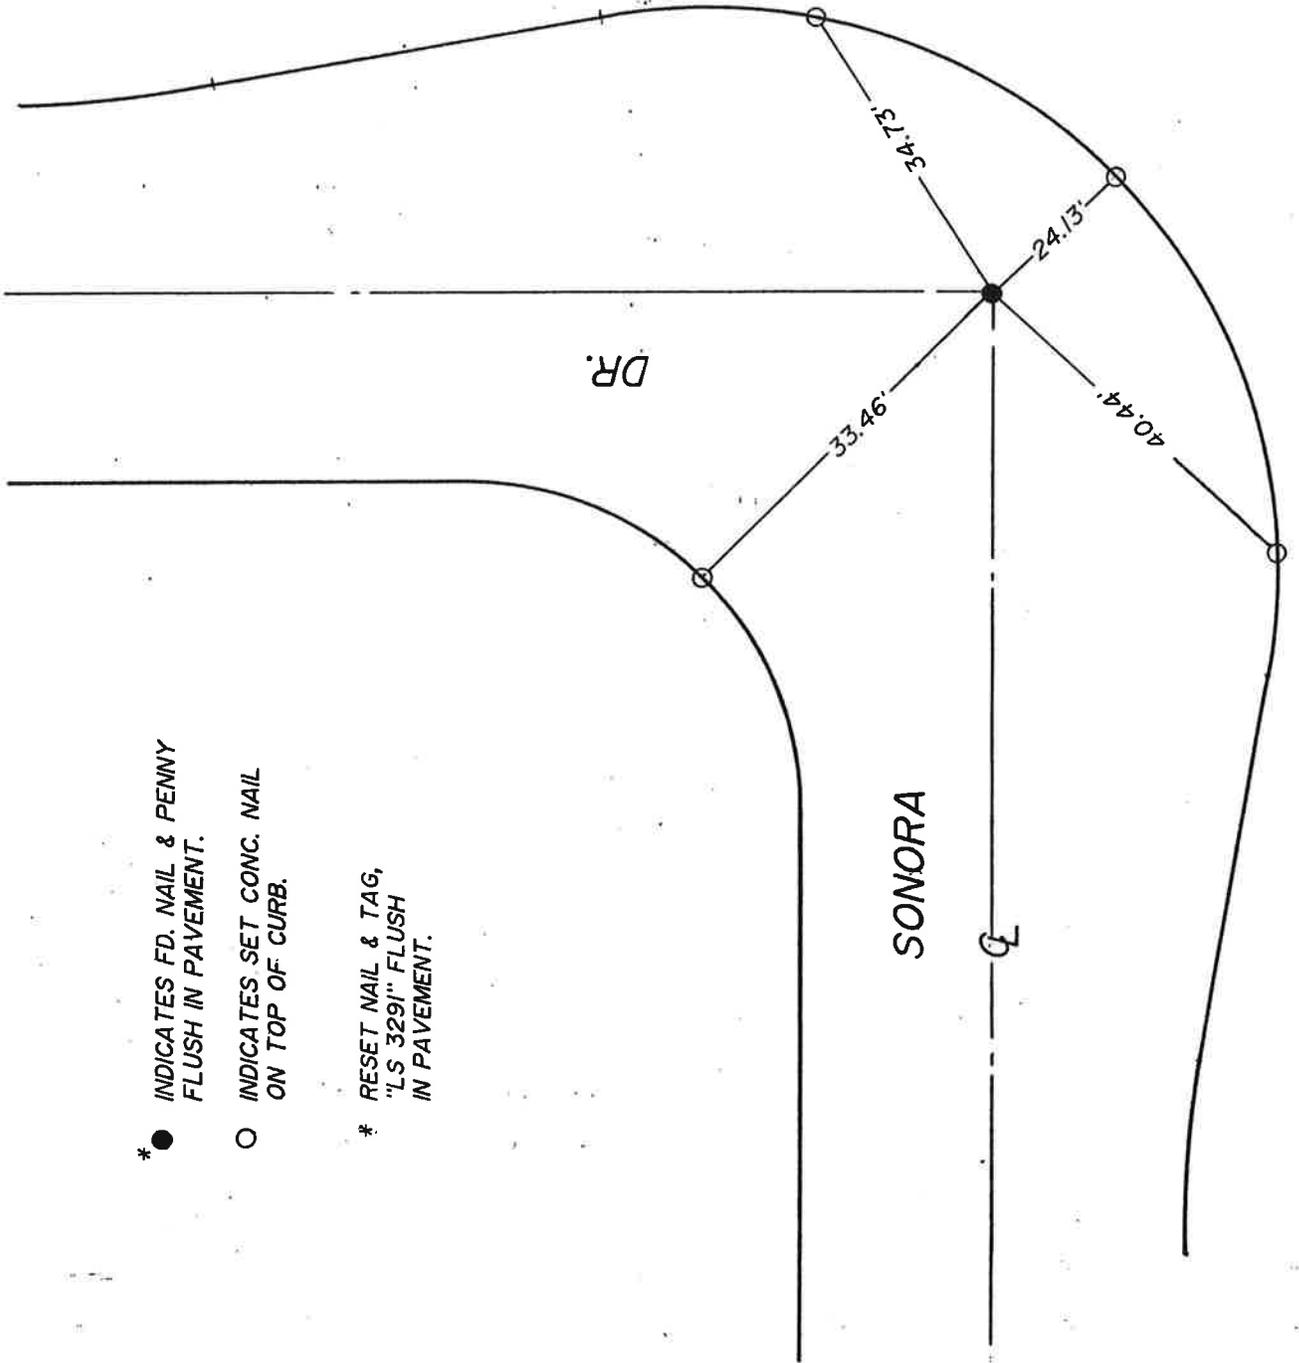

* ● INDICATES FD. NAIL & PENNY
FLUSH IN PAVEMENT.

○ INDICATES SET CONC. NAIL
ON TOP OF CURB.

* RESET NAIL & TAG,
"LS 329" FLUSH
IN PAVEMENT.


City of Hemet



480 EAST LATHAM AVENUE • HEMET, CALIFORNIA 92343 • (714) 858-0611

MONUMENT TIES

SECTION 9 TWP 5S RANGE 1W

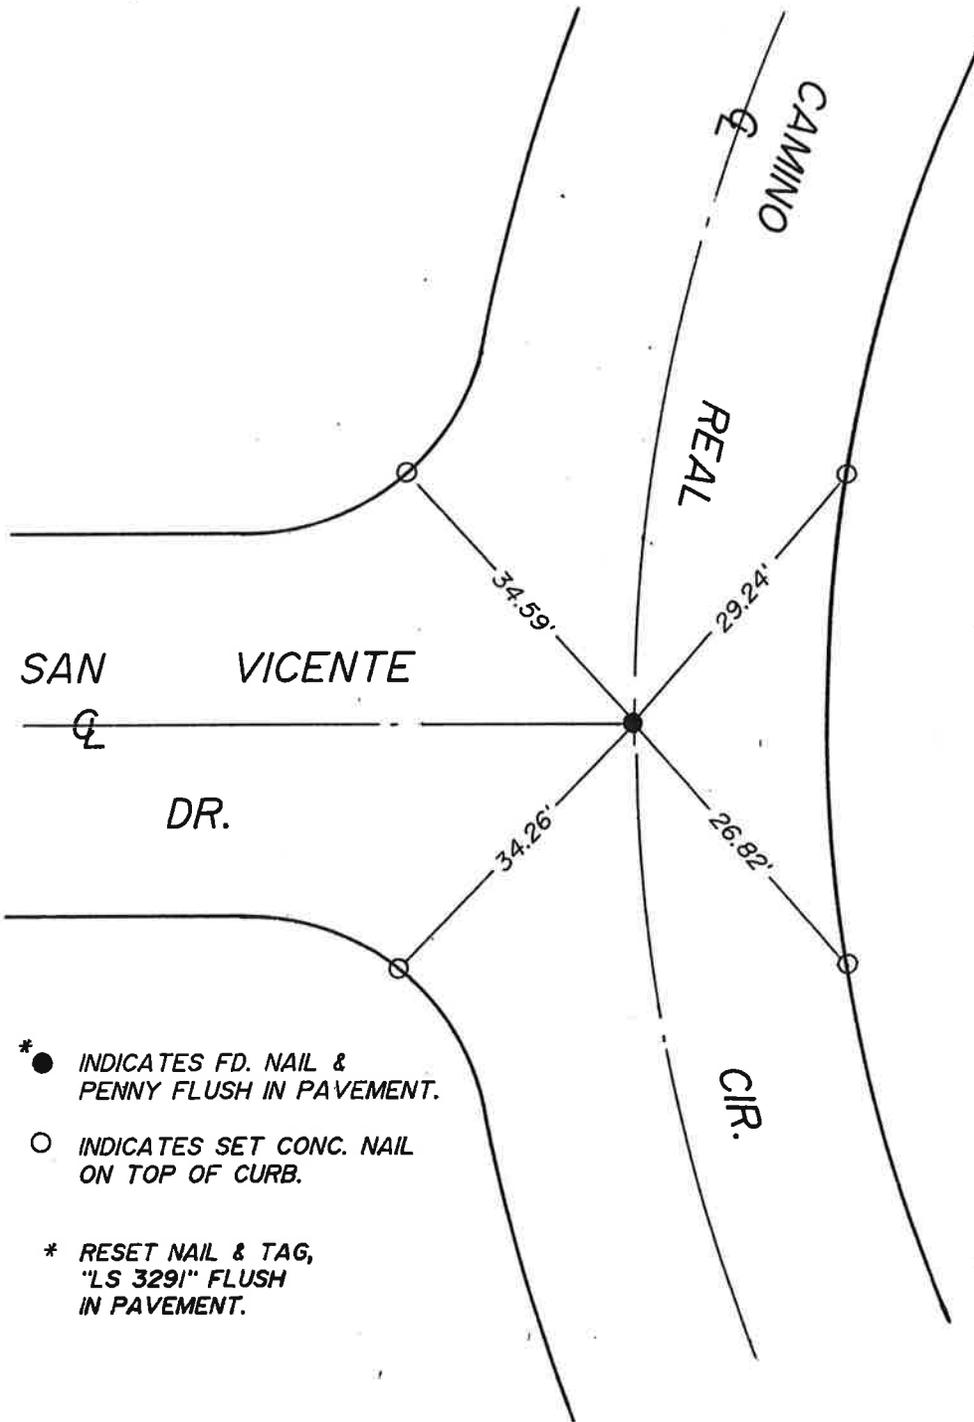

- * ● INDICATES FD. NAIL & PENNY FLUSH IN PAVEMENT.
- INDICATES SET CONC. NAIL ON TOP OF CURB.
- * RESET NAIL & TAG, "LS 329" FLUSH IN PAVEMENT.

City of Hemet

488 EAST LATHAM AVENUE • HEMET, CALIFORNIA 92343 • (714) 658-8411

